


THIS DRAWING IS COPYRIGHT AND THE PROPERTY OF FLANAGAN CONSULTING GROUP, A REGISTERED BUSINESS NAME OF SOUTH PACIFICSANDS PTY. LTD. (ACN 052 933 687) AND MUST NOT BE REPRODUCED WITHOUT WRITTEN PERMISSION.				
REV	DESCRIPTION	TASK MAN.	APPROVED	RPEQ No. DATE
B	AS CONSTRUCTED		TN	01/12/16
A	ISSUED FOR CONSTRUCTION	-	BG	06/05/16

ASSOCIATED CONSULTANTS				

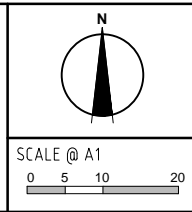

CLIENT / PROJECT

**ZUCCOLI 5
PRECINCT A**


FLANAGAN CONSULTING GROUP
DEVELOPMENT CONSULTANTS • PROJECT MANAGERS • ENGINEERS • PLANNERS

CAIRNS (08) 4031 3199 DARWIN (08) 8911 0046 MACKAY (07) 4944 1200 TOWNSVILLE (07) 4724 5737
www.flanaganconsulting.com.au

DESIGNED R. TAIT
DRAWN C. HAYWOOD
ACAD No. 30030087E-A-601
SCALE AS NOTED

TITLE CITY OF PALMERSTON SERVICES MASTER SERVICES PLAN		REVISION B
DESIGNED R. TAIT	DRAWN C. HAYWOOD	
ACAD No. 30030087E-A-601	DRAWING No. 30030087E-A-601	
SCALE AS NOTED	SHEET 1 OF 1 SHEETS	

PRINT DATE: 6/12/2016 8:04:11 AM
USER: PAUL.WILKS
FILE LOCATION: G:\3000-4999\4400-4499\4493 Zuccoli Aspire Subdivision Design Data\As Cons Prec AB\30030087E-B-401.dwg

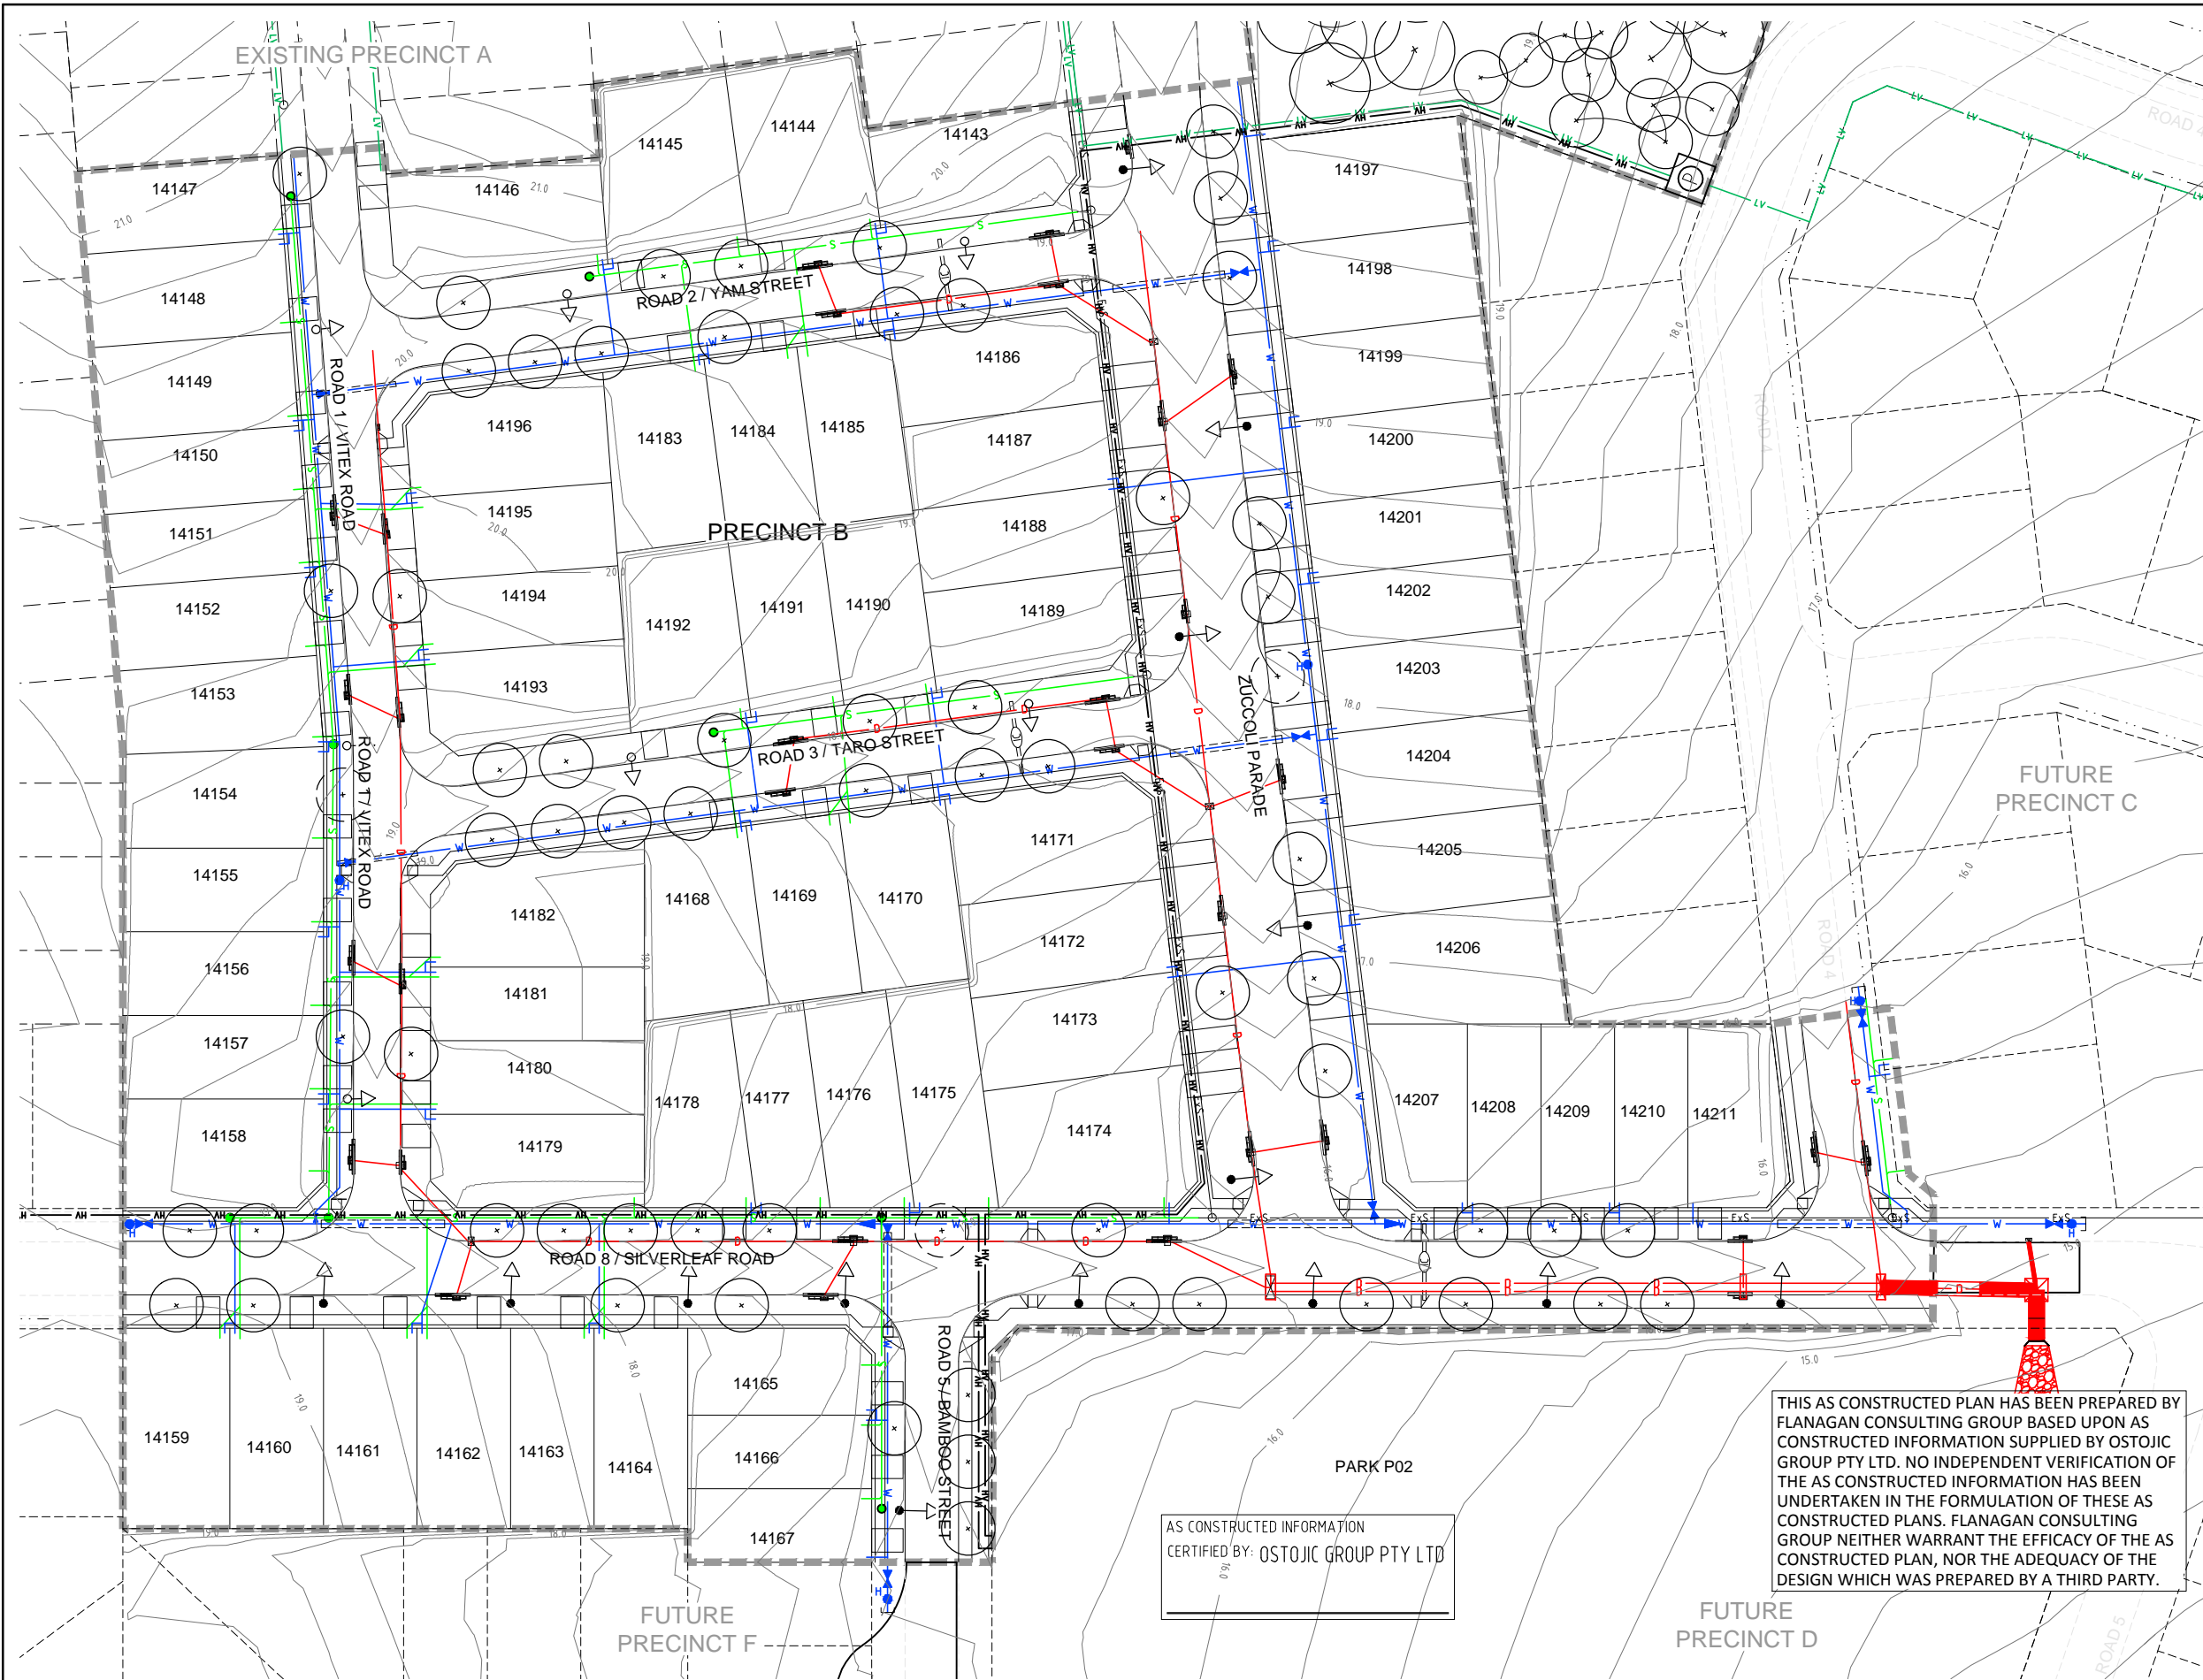


AS CONSTRUCTED INFORMATION
CERTIFIED BY: OSTOJIC GROUP PTY LTD

THIS AS CONSTRUCTED PLAN HAS BEEN PREPARED BY FLANAGAN CONSULTING GROUP BASED UPON AS CONSTRUCTED INFORMATION SUPPLIED BY OSTOJIC GROUP PTY LTD. NO INDEPENDENT VERIFICATION OF THE AS CONSTRUCTED INFORMATION HAS BEEN UNDERTAKEN IN THE FORMULATION OF THESE AS CONSTRUCTED PLANS. FLANAGAN CONSULTING GROUP NEITHER WARRANTS THE EFFICACY OF THE AS CONSTRUCTED PLAN, NOR THE ADEQUACY OF THE DESIGN WHICH WAS PREPARED BY A THIRD PARTY.

LEGEND

- PROPOSED KERB AND GUTTER
- STORMWATER DRAINAGE
- PROPOSED SEWER MAIN, MANHOLE AND PROPERTY CONNECTION
- PROPOSED WATER MAIN, VALVE, FIRE HYDRANT AND HOUSE CONNECTION
- PROPOSED WATER IRRIGATION CONDUIT
- RECYCLED WATER CONDUIT
- PROPOSED DCL CROSSING
- EXISTING ELECTRICAL LV LAYOUT
- EXISTING ELECTRICAL HV LAYOUT
- PROPOSED STREET LIGHT
- EXISTING WATER SUPPLY
- EXISTING SEWER SUPPLY
- WORKS BOUNDARY
- PROPOSED STREET TREE
- PROPOSED ELECTRICAL PILLAR
- PROPOSED TRIPLE FUSE DISTRIBUTION PILLAR

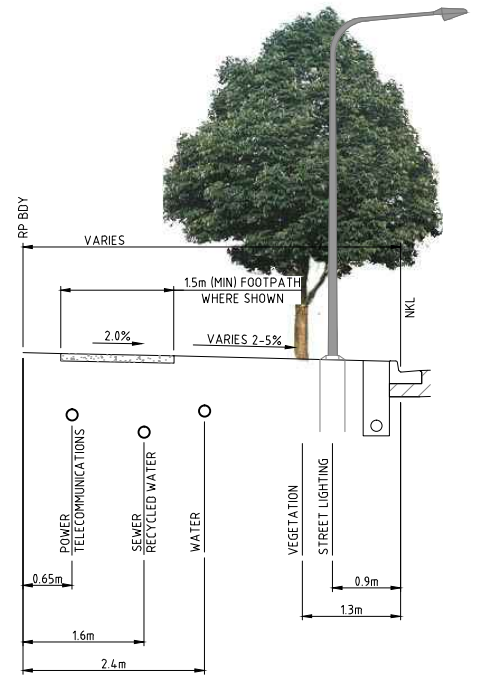

TYPICAL ROAD RESERVE SERVICE
TRENCH DETAIL
1:50

PWC DRG No. B15-15976

PERMISSION TO USE FOR CONSTRUCTION PURPOSES ONLY

SIGNED DATE
ON BEHALF OF WATER SERVICES FOR THE INCORPORATION INTO POWER AND WATER CORPORATION'S NETWORK.

This permission to Use this Approved Design is given on the basis that the developer and/or Consultant is not absolved from full responsibility for the correctness and accuracy of the design and/or document so associated.


This drawing is valid for 2 years from the date of signing.

DEV. APP. No. DP15/0587

REV	DESCRIPTION	TASK MAN.	APPROVED	RPEQ No.	DATE
B	AS CONSTRUCTED		TN		01/12/16
A	ISSUED FOR CONSTRUCTION		BG		06/05/16

THIS DRAWING IS COPYRIGHT AND THE PROPERTY OF FLANAGAN CONSULTING GROUP, A REGISTERED BUSINESS NAME OF SOUTH PACIFIC SANDS PTY. LTD. (ACN 052 933 687) AND MUST NOT BE REPRODUCED WITHOUT WRITTEN PERMISSION.

ASSOCIATED CONSULTANTS

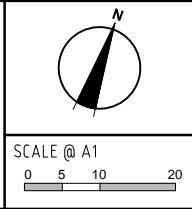

CLIENT / PROJECT

**ZUCCOLI 5
PRECINCT B**

FLANAGAN CONSULTING GROUP

DEVELOPMENT CONSULTANTS • PROJECT MANAGERS • ENGINEERS • PLANNERS

CAIRNS (08) 4031 3199 DARWIN (08) 8911 0046 MACKAY (07) 4944 1200 TOWNSVILLE (07) 4724 5737

www.flanaganc consulting.com.au

DESIGNED R. TAIT
DRAWN C. HAYWOOD
ACAD No. 30030087E-B-401
SCALE AS NOTED

TITLE CITY OF PALMERSTON SERVICES MASTER SERVICES PLAN	DRAWING No. 30030087E-B-401	REVISION B
A1 FULL SIZE	SHEET 1 OF 1 SHEETS	