


PRINT DATE: 1/03/2017 4:09:48 PM
USER: PAUL.WILKS
FILE LOCATION: G:\3000-5999\4400-4499\4493 Zuccoli Aspire Subdivision\Design Data\As Cons Prec AB\30030087E-A-101_B.dwg



REV	DESCRIPTION	TASK MAN.	APPROVED	RPEQ No.	DATE
B	AS CONSTRUCTED		TN		21/02/17
A	ISSUED FOR CONSTRUCTION	-	BG	-	18/03/16

ASSOCIATED CONSULTANTS

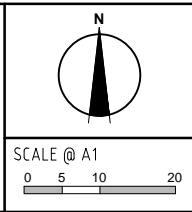

CLIENT / PROJECT

**ZUCCOLI 5
PRECINCT A**

FLANAGAN CONSULTING GROUP
DEVELOPMENT CONSULTANTS • PROJECT MANAGERS • ENGINEERS • PLANNERS

CAIRNS (08) 4031 3199 DARWIN (08) 8911 0046 MACKAY (07) 4944 1200 TOWNSVILLE (07) 4724 5737
www.flanaganconsulting.com.au

DESIGNED R. TAIT
DRAWN C. HAYWOOD
ACAD No. 30030087E-A-101
SCALE AS NOTED


TITLE CITY OF PALMERSTON EARTHWORKS LAYOUT PLAN	DRAWING No. 30030087E-A-101	REVISION B
A1 FULL SIZE	SHEET 1 OF 1 SHEETS	

WARNING
BEWARE OF UNDERGROUND SERVICES
The locations of underground services are approximate only and their exact position should be proven on site.
No guarantee is given that all existing services are shown. Locate all underground services before commencement of works
DIAL 1100 BEFORE YOU DIG
www.1100.com.au
DEV. APP. No. DP15/0587

THIS AS CONSTRUCTED PLAN HAS BEEN PREPARED BY FLANAGAN CONSULTING GROUP BASED UPON AS CONSTRUCTED INFORMATION SUPPLIED BY OSTOJIC GROUP PTY LTD. NO INDEPENDENT VERIFICATION OF THE AS CONSTRUCTED INFORMATION HAS BEEN UNDERTAKEN IN THE FORMULATION OF THESE AS CONSTRUCTED PLANS. FLANAGAN CONSULTING GROUP NEITHER WARRANT THE EFFICACY OF THE AS CONSTRUCTED PLAN, NOR THE ADEQUACY OF THE DESIGN WHICH WAS PREPARED BY A THIRD PARTY.


AS CONSTRUCTED INFORMATION
CERTIFIED BY: OSTOJIC GROUP PTY LTD

PRINT DATE: 2/03/2017 4:25:03 PM
USER: PAUL WILKS
FILE LOCATION: G:\3000-1999\4400-4499\4493 Zuccoli Aspire Subdivision\Design Data\As Cons Prec AB\30030087E-B-101_B.dwg

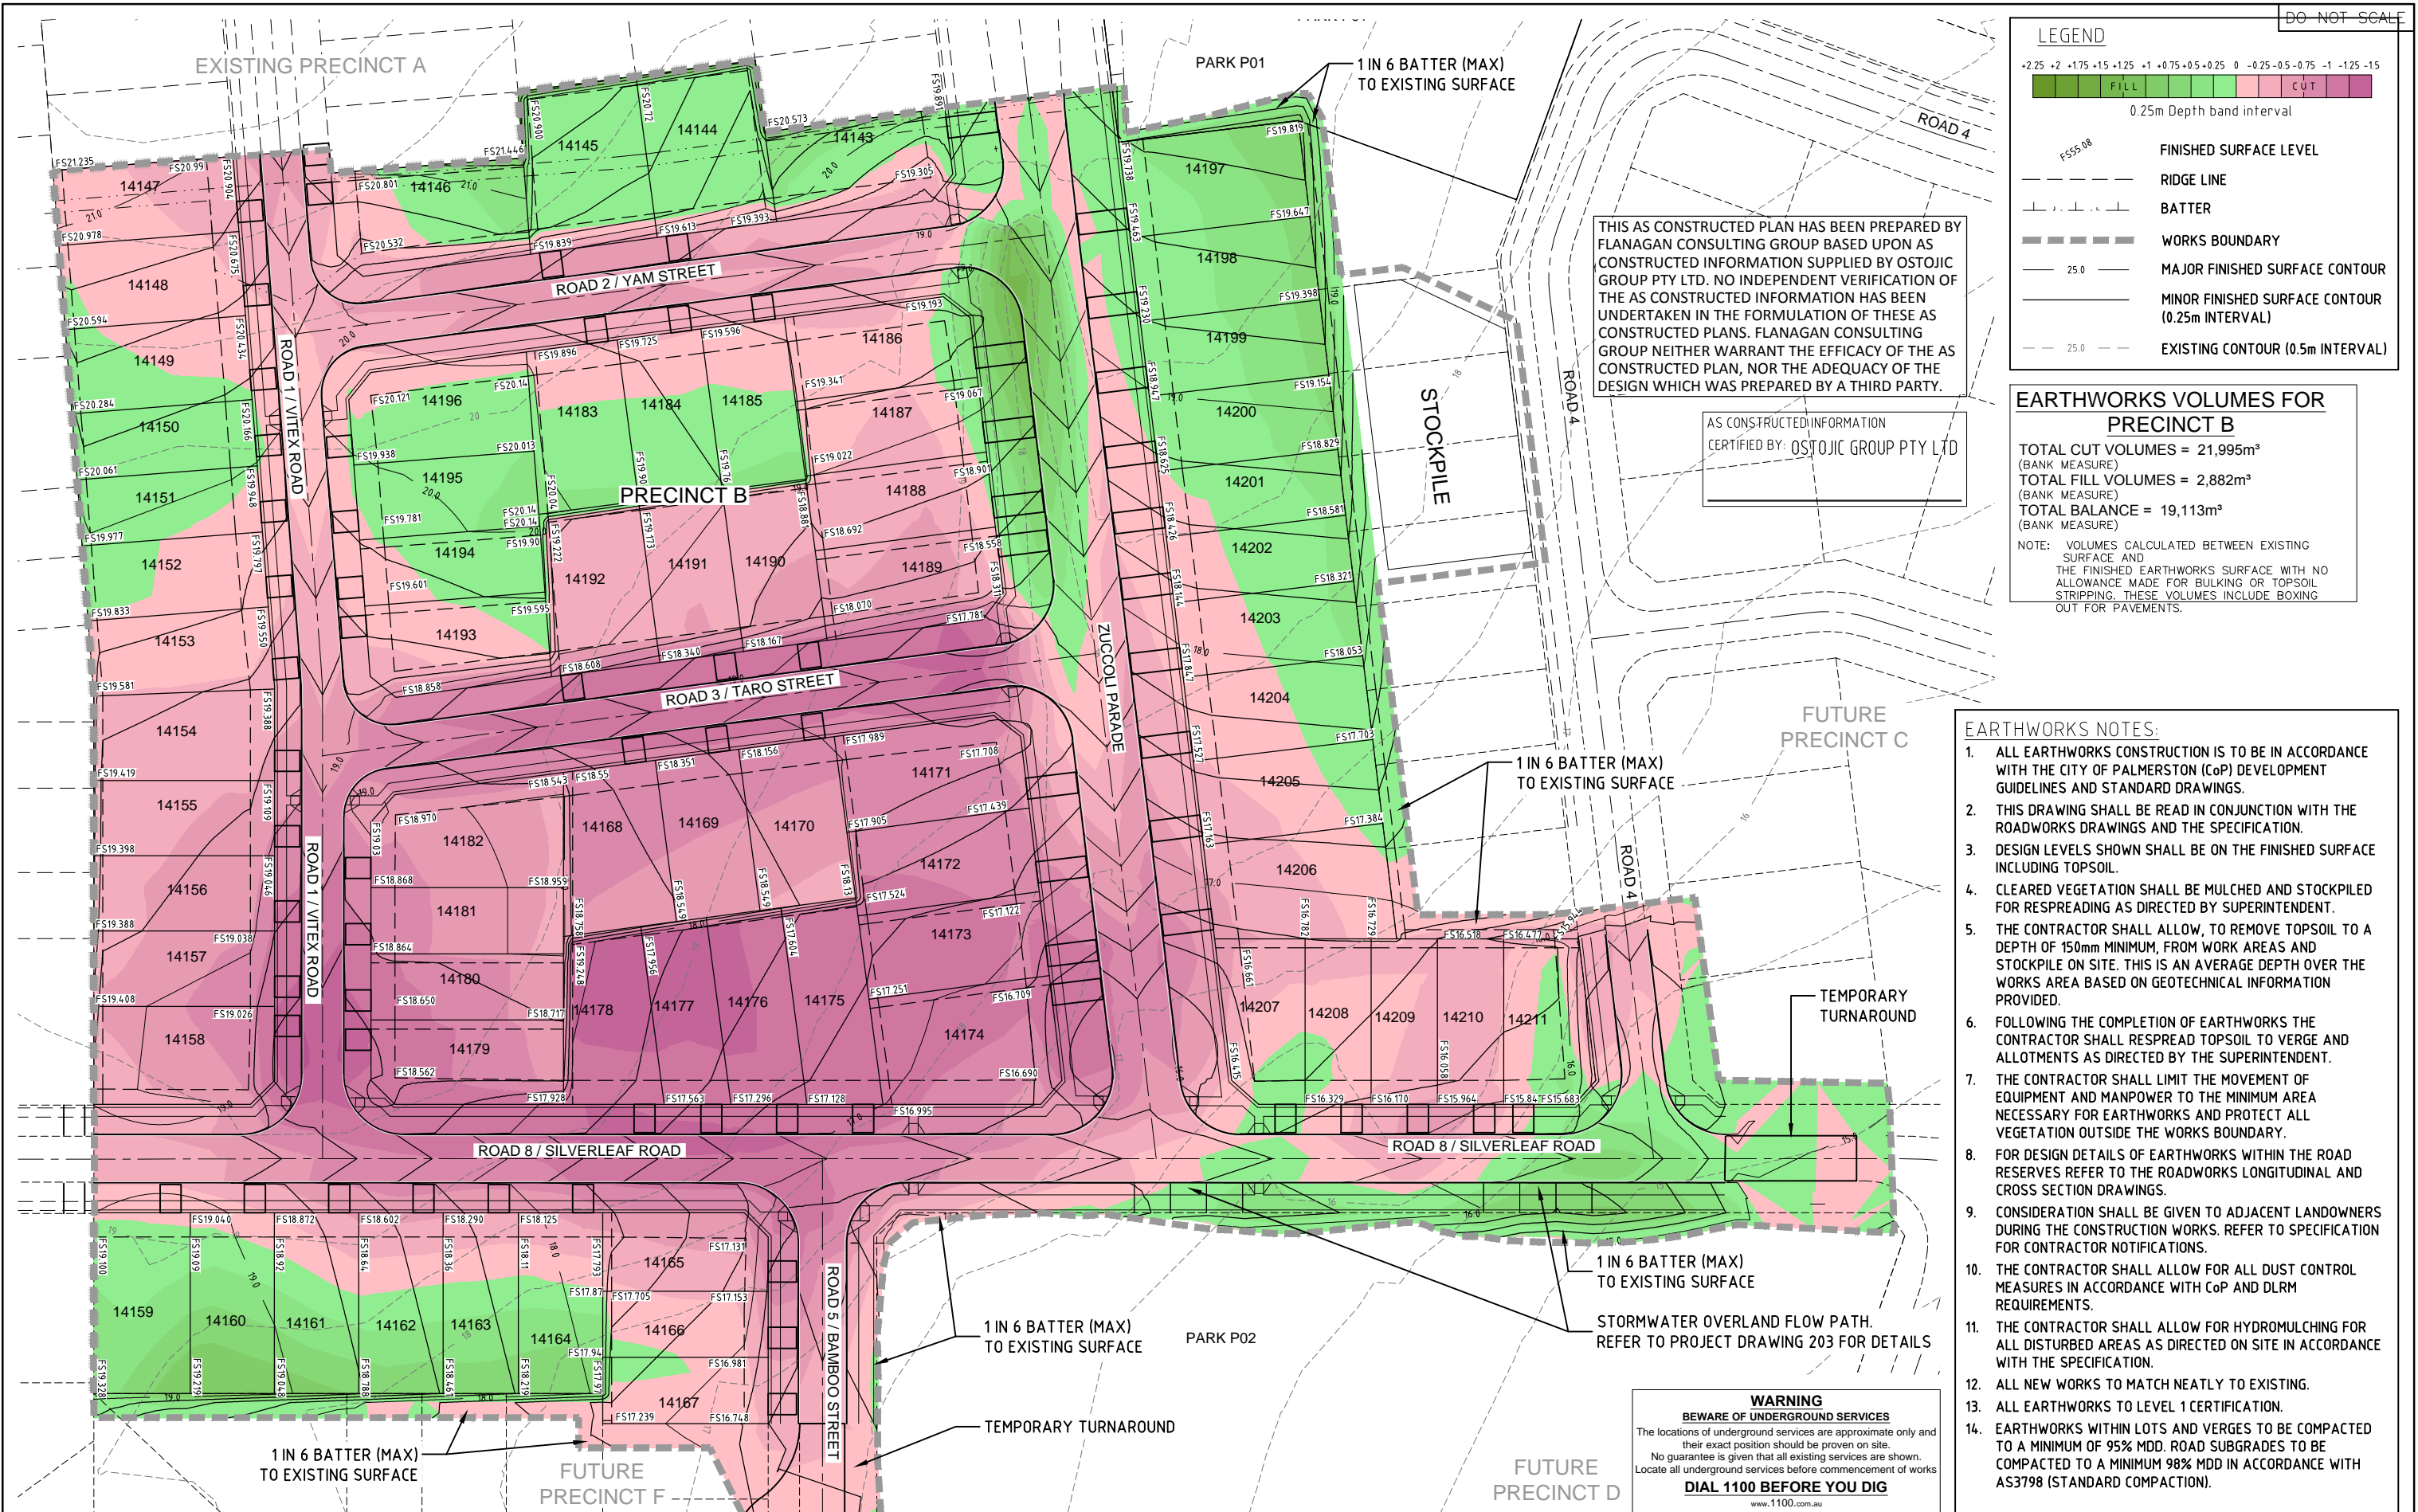

B	AS CONSTRUCTED			TN		21/02/17
A	ISSUED FOR CONSTRUCTION			-	BG	-
						06/05/16
REV	DESCRIPTION			TASK MAN.	APPROVED	RPEQ No. DATE
THIS DRAWING IS COPYRIGHT AND THE PROPERTY OF FLANAGAN CONSULTING GROUP, A REGISTERED BUSINESS NAME OF SOUTH PACIFIC SANDS PTY. LTD. (ACN 052 933 687) AND MUST NOT BE REPRODUCED WITHOUT WRITTEN PERMISSION.						

ASSOCIATED CONSULTANTS	
CLIENT / PROJECT	

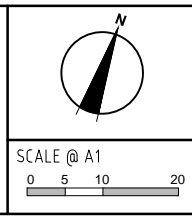

ZUCCOLI 5
PRECINCT B

FLANAGAN CONSULTING GROUP
DEVELOPMENT CONSULTANTS • PROJECT MANAGERS • ENGINEERS • PLANNERS
CAIRNS (08) 4031 3199 DARWIN (08) 8911 0046 MACKAY (07) 4944 1200 TOWNSVILLE (07) 4724 5737
www.flanaganc consulting.com.au

DESIGNED R. TAIT
DRAWN C. HAYWOOD
ACAD No. 30030087E-B-101
SCALE AS NOTED

TITLE			
CITY OF PALMERSTON EARTHWORKS LAYOUT PLAN			
A1 FULL SIZE		DRAWING No. 30030087E-B-101	REVISION B
		SHEET 1 OF 1 SHEETS	