

AS CONSTRUCTED INFORMATION IS CERTIFIED BY:
OSTOJIC GROUP PTY LTD

SIGNED DATE

FLANAGAN CONSULTING GROUP HAS PREPARED THESE DRAWINGS BASED UPON THE INFORMATION SUPPLIED BY THE CONTRACTOR. NO INDEPENDENT VERIFICATION OF THE AS CONSTRUCTED INFORMATION HAS BEEN UNDERTAKEN IN THE FORMULATION OF THESE DRAWINGS. FLANAGAN CONSULTING GROUP TAKES NO RESPONSIBILITY FOR THE ACCURACY OR COMPLETENESS OF THE INFORMATION PROVIDED BY THE CONTRACTOR, INCLUDING (BUT NOT LIMITED TO) ERRORS IN, OR OMISSIONS FROM, THE DRAWINGS, WHICH WERE CAUSED BY THIS INFORMATION.

LEGEND

- Stormwater Drainage
- Stormwater Property Connections
- Water Reticulation
- Sewerage Reticulation
- Electrical
- Street Light
- Electrical Pillar
- Electrical Substation
- Proposed Driveway Location
- Irrigation Conduit
- W/E Water over Electrical
- W/D Water over Drainage
- W/S Water over Sewer
- D/E Drainage over Electrical
- D/S Drainage over Sewer
- D/W Drainage over Water
- E/S Electrical over Sewer
- PC/E Existing Sewer Property Connection over Electrical

NOTES

- Refer Drainage, Water & Sewer Plans for details of service crossings and setout information.

WARNING
BEWARE OF SERVICES

The locations of all existing services are approximate only and their exact position should be proven on site. No guarantee is given that all existing services are shown.

DIAL 1100
BEFORE YOU DIG

PERMISSION TO USE FOR CONSTRUCTION PURPOSES

SIGNED D. Buentipo DATE 22/9/16

ON BEHALF OF WATER SERVICES FOR THE INCORPORATION INTO POWER AND WATER CORPORATION'S NETWORK


This permission to use is given on the basis that the Developer and/or Consultant is not absolved from full responsibility for the correctness and accuracy of the design and/or documents associated. This permission is valid for two years from date of signing.

DESIGN CERTIFICATION

CERTIFIER'S NAME: LUKE MUIR

PWC ACCREDITATION CODE: DESCRTBL38

DATE: 21/09/2016 SIGNATURE: _____

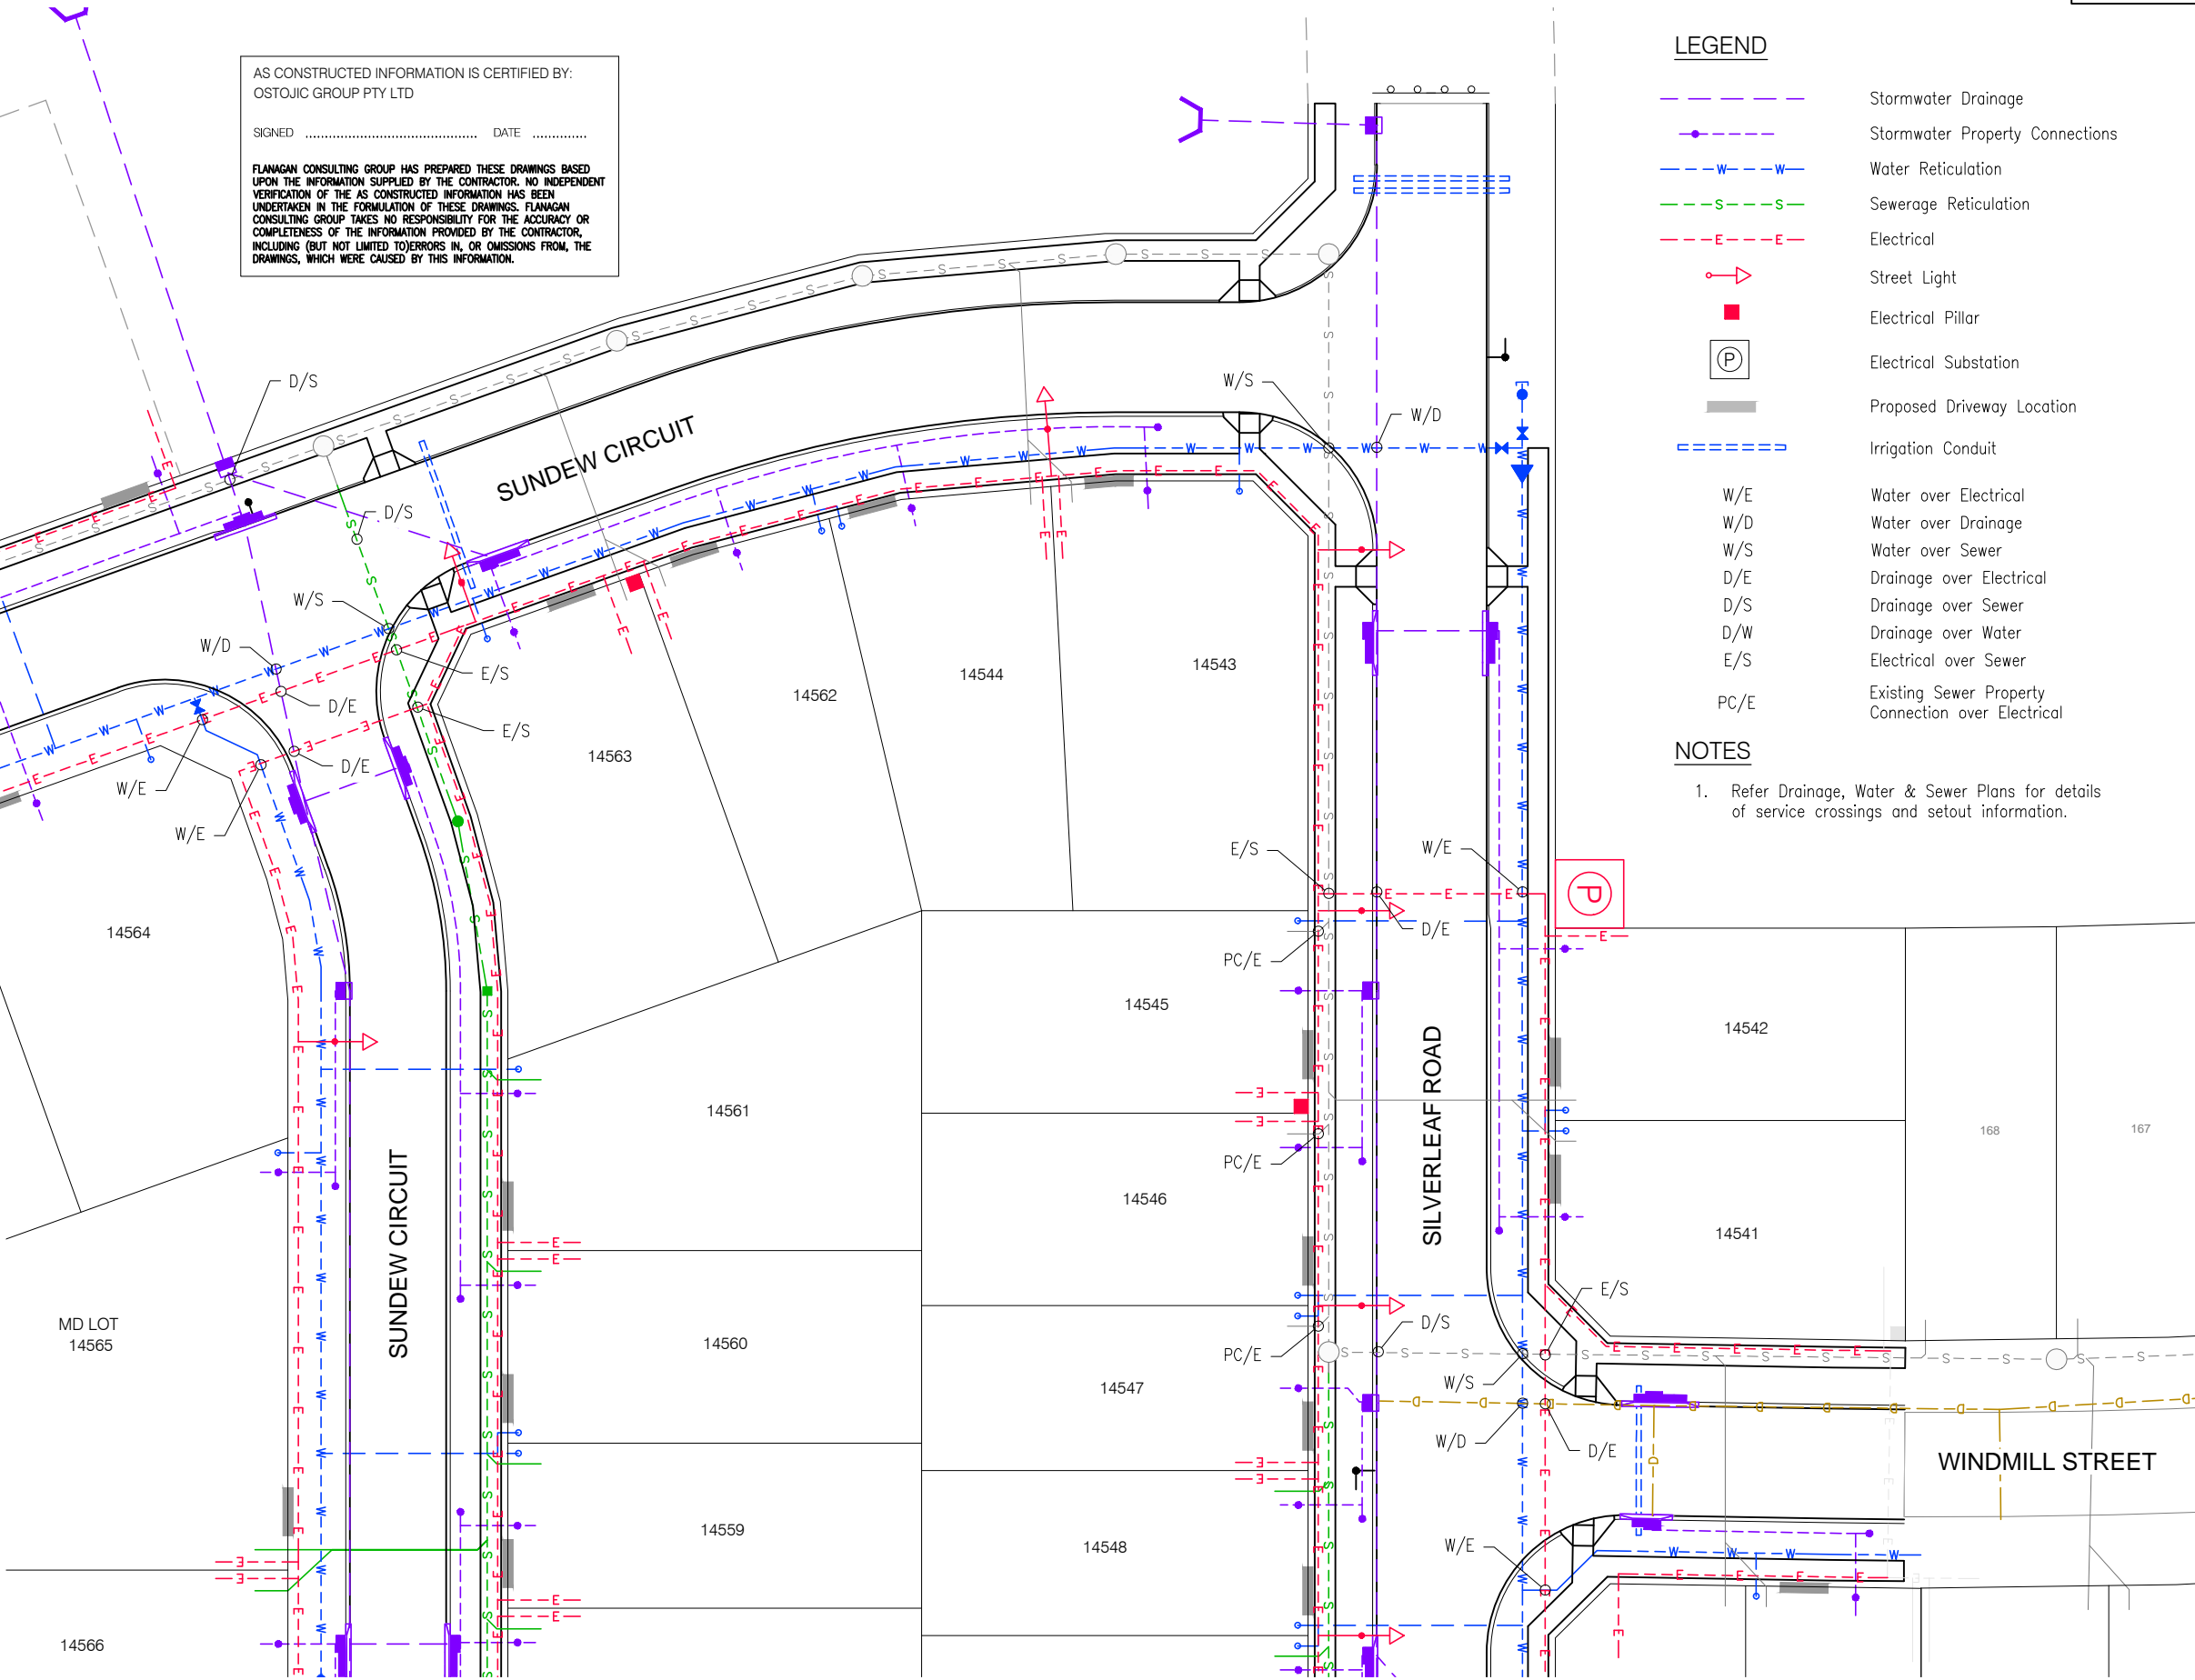

For Continuation Refer Drg C45

XREFS :- X-4493_05b_01 XBASE.dwg : X-4493_02a_01 BASE.dwg : X-4493_01_01 XBASE.dwg

REV	DESCRIPTION	TASK MAN.	APPROVED	DATE
3	AS CONSTRUCTED	LM	LM	02/8/17
2	LOT NUMBERS AND STREET NAMES ADDED	LM	LM	31/01/17
1	ELECTRICAL LAYOUT AMENDED	LM	LM	13/12/16
0	ISSUED FOR CONSTRUCTION	LM	LM	22/9/16

THIS DRAWING IS COPYRIGHT AND THE PROPERTY OF FLANAGAN CONSULTING GROUP, A REGISTERED BUSINESS NAME OF SOUTH PACIFICSANDS PTY. LTD. (ACN 052 933 687) AND MUST NOT BE REPRODUCED WITHOUT WRITTEN PERMISSION.

ASSOCIATED CONSULTANTS	

CLIENT / PROJECT

zuccoli aspire COSTOJIC Pty Ltd
Stage 2A - Civilworks

FLANAGAN CONSULTING GROUP

DEVELOPMENT CONSULTANTS • PROJECT MANAGERS • ENGINEERS • PLANNERS

CAIRNS (07) 4031 3199 DARWIN (08) 8943 0620 MACKAY (07) 4944 1200 TOWNSVILLE (07) 4724 5737

www.flanaganc consulting.com.au

DESIGNED	TITLE		
IRM	MASTER SERVICES PLAN		
DRAWN	SHEET 1 OF 3		
IRM			
ACAD No.	4493-34-2-C44	DRAWING No.	4493-34-2-C44
SCALE	1:250	PWC DRG No.	B16-10076
		REVISION	3

LEGEND

- Stormwater Drainage
--- Stormwater Property Connections
--- W --- Water Reticulation
--- S --- Sewerage Reticulation
--- E --- Electrical
--- Street Light
--- Electrical Pillar
--- Electrical Substation
--- Proposed Driveway Location
--- Irrigation Conduit
- W/E Water over Electrical
W/D Water over Drainage
W/S Water over Sewer
D/E Drainage over Electrical
D/S Drainage over Sewer
D/W Drainage over Water
E/S Electrical over Sewer
PC/E Existing Sewer Property Connection over Electrical

NOTES

1. Refer Drainage, Water & Sewer Plans for details of service crossings and setout information.



WARNING

BEWARE OF SERVICES

The locations of all existing services are approximate only and their exact position should be proven on site. No guarantee is given that all existing services are shown.

PERMISSION TO USE FOR CONSTRUCTION PURPOSES


SIGNED DATE
ON BEHALF OF WATER SERVICES FOR THE INCORPORATION INTO POWER AND WATER CORPORATION'S NETWORK

This permission to use is given on the basis that the Developer and/or Consultant is not absolved from full responsibility for the correctness and accuracy of the design and/or documents associated. This permission is valid for two years from date of signing.

AS CONSTRUCTED INFORMATION IS CERTIFIED BY:
OSTOJIC GROUP PTY LTD

SIGNED D. Buentipo DATE 22/9/16

FLANAGAN CONSULTING GROUP HAS PREPARED THESE DRAWINGS BASED UPON THE INFORMATION SUPPLIED BY THE CONTRACTOR. NO INDEPENDENT VERIFICATION OF THE AS CONSTRUCTED INFORMATION HAS BEEN UNDERTAKEN IN THE FORMULATION OF THESE DRAWINGS. FLANAGAN CONSULTING GROUP TAKES NO RESPONSIBILITY FOR THE ACCURACY OR COMPLETENESS OF THE INFORMATION PROVIDED BY THE CONTRACTOR, INCLUDING (BUT NOT LIMITED TO) ERRORS IN, OR OMISSIONS FROM, THE DRAWINGS, WHICH WERE CAUSED BY THIS INFORMATION.

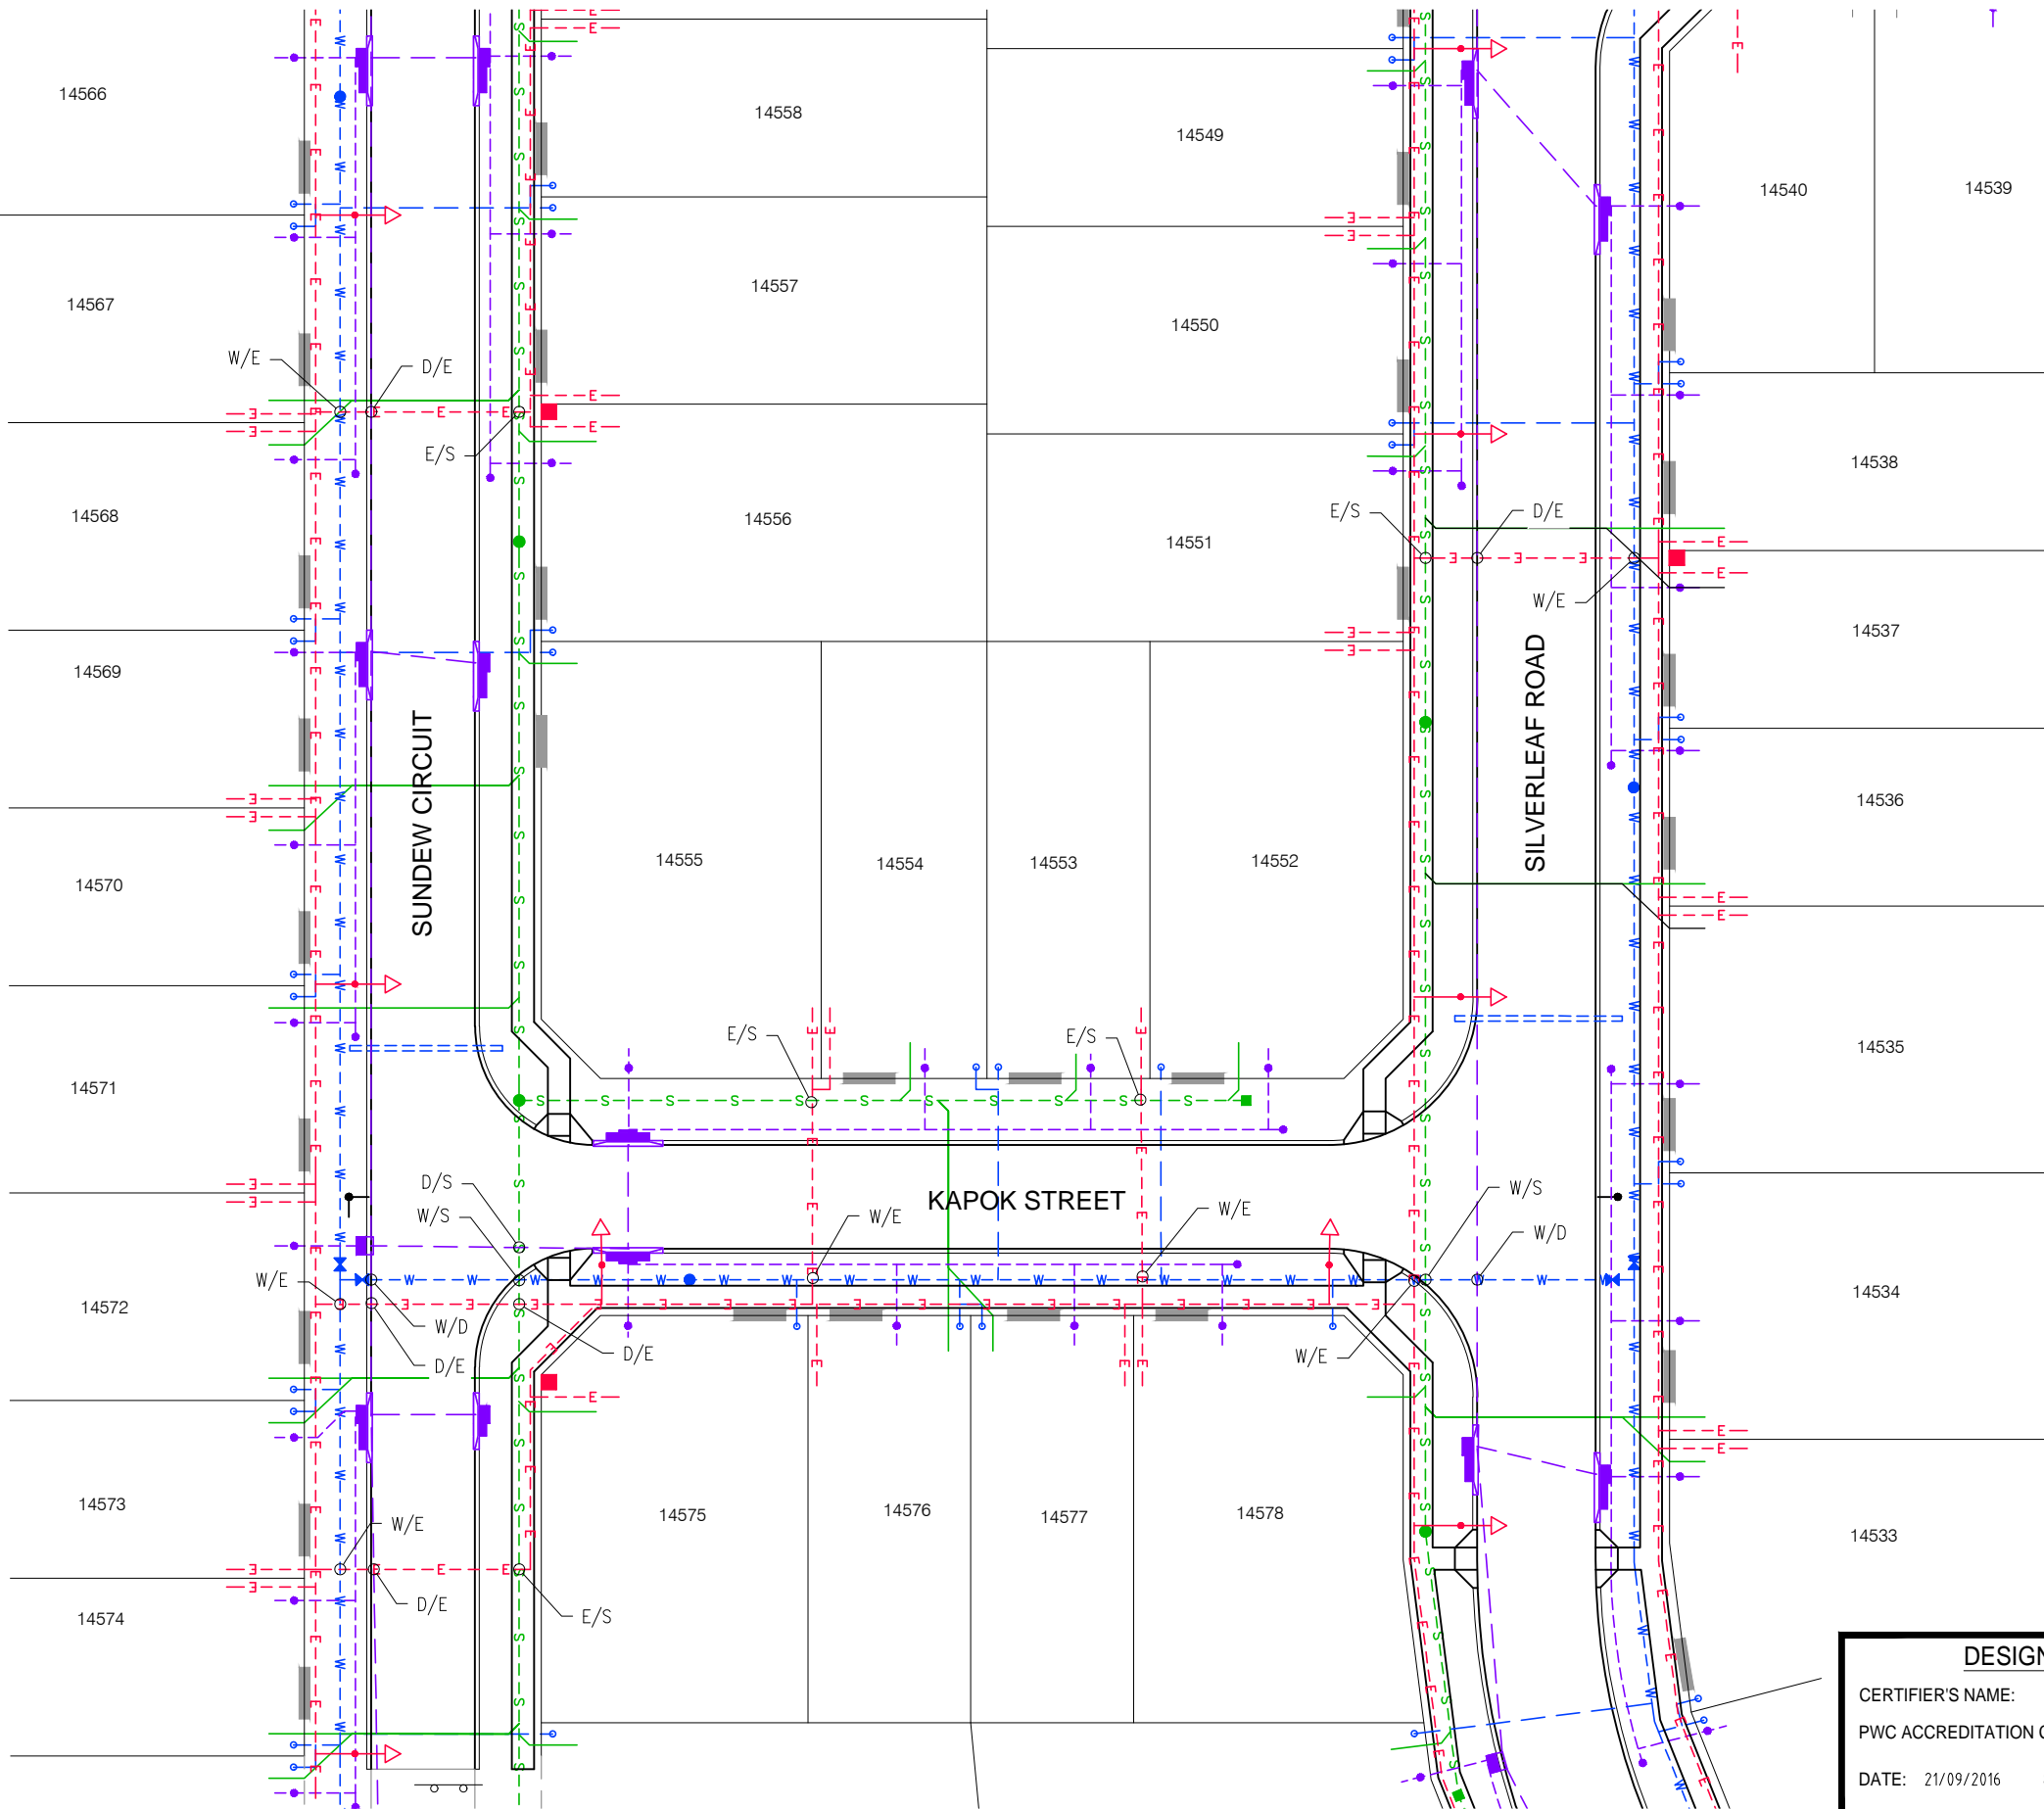

For Continuation Refer Drg C46

DESIGN CERTIFICATION

CERTIFIER'S NAME: LUKE MUIR
PWC ACCREDITATION CODE: DESCERTBL38
DATE: 21/09/2016 SIGNATURE: _____

XREFS :- X-4493_05b_01 XBASE.dwg : X-4493_02a_01 BASE.dwg : X-4493_01_01 XBASE.dwg

REV	DESCRIPTION	TASK MAN.	APPROVED	DATE
3	AS CONSTRUCTED	LM	LM	02/8/17
2	LOT NUMBERS AND STREET NAMES ADDED	LM	LM	31/01/17
1	ELECTRICAL LAYOUT AMENDED	LM	LM	13/12/16
0	ISSUED FOR CONSTRUCTION	LM	LM	6/6/16

ASSOCIATED CONSULTANTS

CLIENT / PROJECT



COSTOJIC Pty Ltd
Stage 2A - Civilworks



DESIGNED	TITLE	REVISION
IRM	MASTER SERVICES PLAN	
DRAWN	SHEET 2 OF 3	
ACAD No.	A1	
4493-34-2-C45	FULL SIZE	
SCALE	DRAWING No.	
1:250	4493-34-2-C45	
	PWC DRG No. B16-10077	3



NOTES

1. Refer Drainage, Water & Sewer Plans for details of service crossings and setout information.

AS CONSTRUCTED INFORMATION IS CERTIFIED BY:
OSTOJIC GROUP PTY LTD

SIGNED DATE

FLANAGAN CONSULTING GROUP HAS PREPARED THESE DRAWINGS BASED UPON THE INFORMATION SUPPLIED BY THE CONTRACTOR. NO INDEPENDENT VERIFICATION OF THE AS CONSTRUCTED INFORMATION HAS BEEN UNDERTAKEN IN THE FORMULATION OF THESE DRAWINGS. FLANAGAN CONSULTING GROUP TAKES NO RESPONSIBILITY FOR THE ACCURACY OR COMPLETENESS OF THE INFORMATION PROVIDED BY THE CONTRACTOR, INCLUDING (BUT NOT LIMITED TO) ERRORS IN, OR OMISSIONS FROM, THE DRAWINGS, WHICH WERE CAUSED BY THIS INFORMATION.



WARNING
BEWARE OF SERVICES
The locations of all existing services are approximate only and their exact position should be proven on site. No guarantee is given that all existing services are shown.

PERMISSION TO USE FOR CONSTRUCTION PURPOSES


SIGNED D. Buentipo DATE 22/9/16

ON BEHALF OF WATER SERVICES FOR THE INCORPORATION INTO POWER AND WATER CORPORATION'S NETWORK

This permission to use is given on the basis that the Developer and/or Consultant is not absolved from full responsibility for the correctness and accuracy of the design and/or documents associated. This permission is valid for two years from date of signing.

LEGEND

- Stormwater Drainage
- Stormwater Property Connections
- Water Reticulation
- Sewerage Reticulation
- Electrical
- Street Light
- Electrical Pillar
- Electrical Substation
- Proposed Driveway Location
- Irrigation Conduit
- W/E Water over Electrical
- W/D Water over Drainage
- W/S Water over Sewer
- D/E Drainage over Electrical
- D/S Drainage over Sewer
- D/W Drainage over Water
- E/S Electrical over Sewer
- PC/E Existing Sewer Property Connection over Electrical

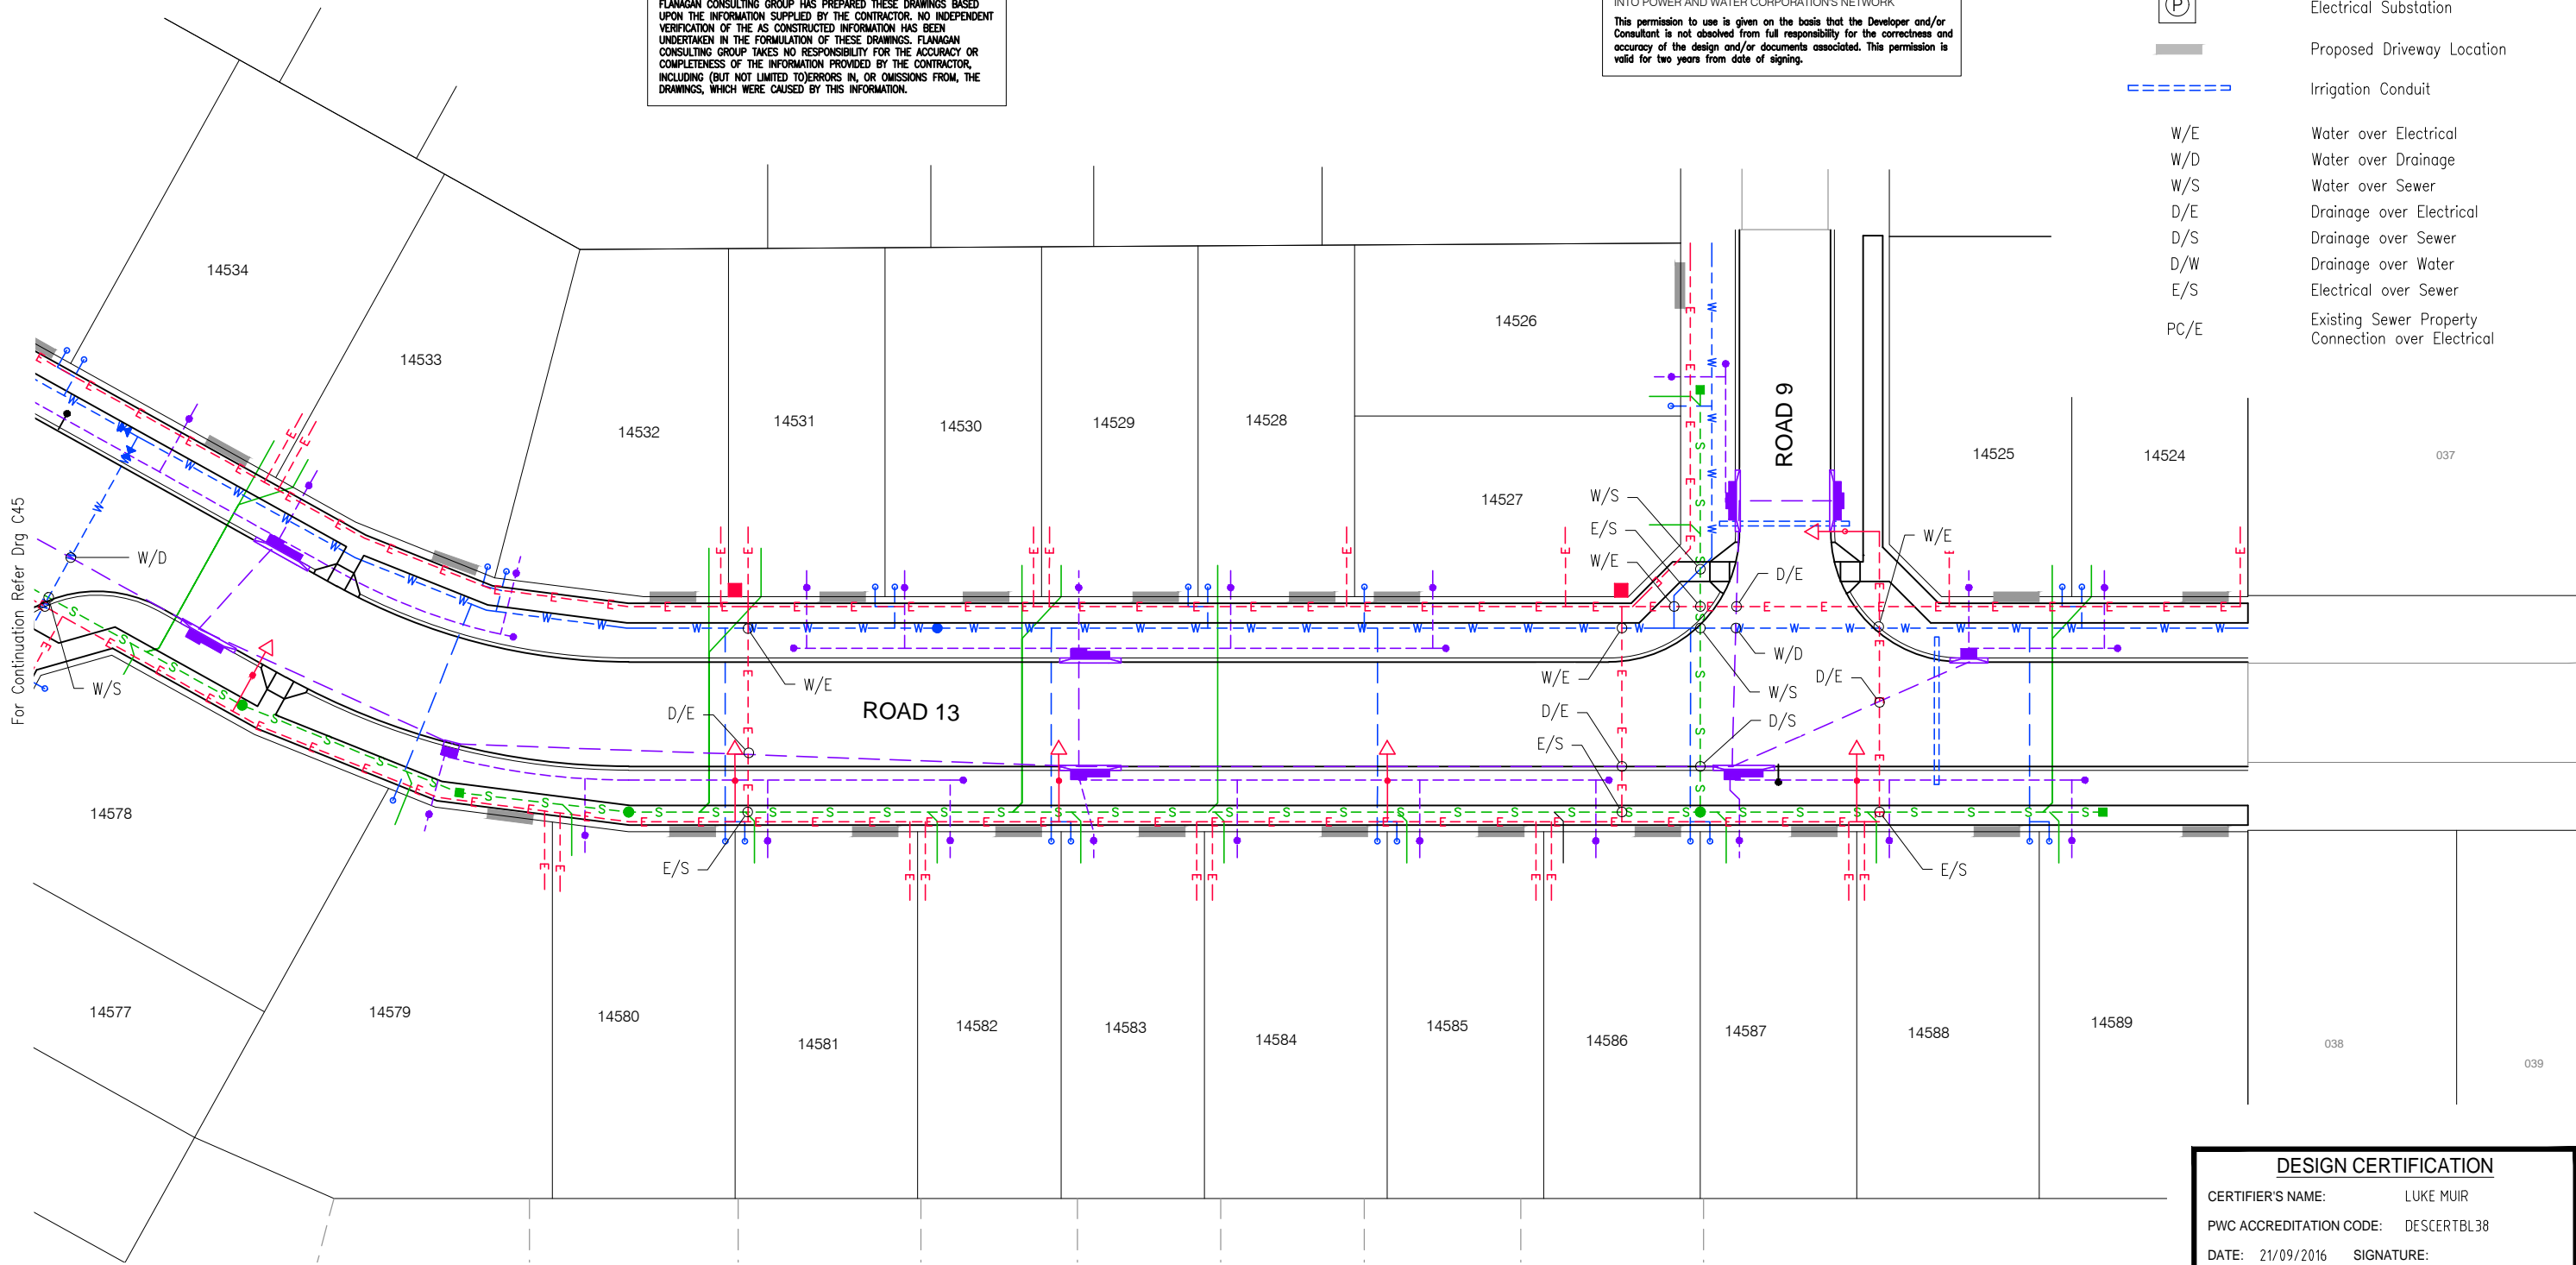

DESIGN CERTIFICATION

CERTIFIER'S NAME: LUKE MUIR
PWC ACCREDITATION CODE: DESCERTBL38
DATE: 21/09/2016 SIGNATURE: _____

REFS :- X-4493_05b_01 XBASE.dwg ; X-4493_02a_01 BASE.dwg ; X-4493_01_01 XBASE.dwg

REV	DESCRIPTION	TASK MAN.	APPROVED	DATE
3	AS CONSTRUCTED	LM	LM	02/8/17
2	LOT NUMBERS AND STREET NAMES ADDED	LM	LM	31/01/17
1	ELECTRICAL LAYOUT AMENDED	LM	LM	13/12/16
0	ISSUED FOR CONSTRUCTION	LM	LM	22/9/16

ASSOCIATED CONSULTANTS

CLIENT / PROJECT



COSTOJIC Pty Ltd
Stage 2A - Civilworks



DESIGNED	TITLE	ACAD No.	DRAWING No.	REVISION
IRM	MASTER SERVICES PLAN SHEET 3 OF 3	4493-34-2-C46	4493-34-2-C46	3
DRAWN			PWC DRG No. B16-10078	
SCALE				
1:250				