


AS CONSTRUCTED INFORMATION IS CERTIFIED BY:  
OSTOJIC GROUP PTY LTD

SIGNED ..... DATE .....

FLANAGAN CONSULTING GROUP HAS PREPARED THESE DRAWINGS BASED UPON THE INFORMATION SUPPLIED BY THE CONTRACTOR. NO INDEPENDENT VERIFICATION OF THE AS CONSTRUCTED INFORMATION HAS BEEN UNDERTAKEN IN THE FORMULATION OF THESE DRAWINGS. FLANAGAN CONSULTING GROUP TAKES NO RESPONSIBILITY FOR THE ACCURACY OR COMPLETENESS OF THE INFORMATION PROVIDED BY THE CONTRACTOR, INCLUDING (BUT NOT LIMITED TO) ERRORS IN, OR OMISSIONS FROM, THE DRAWINGS, WHICH WERE CAUSED BY THIS INFORMATION.

DO NOT SCALE

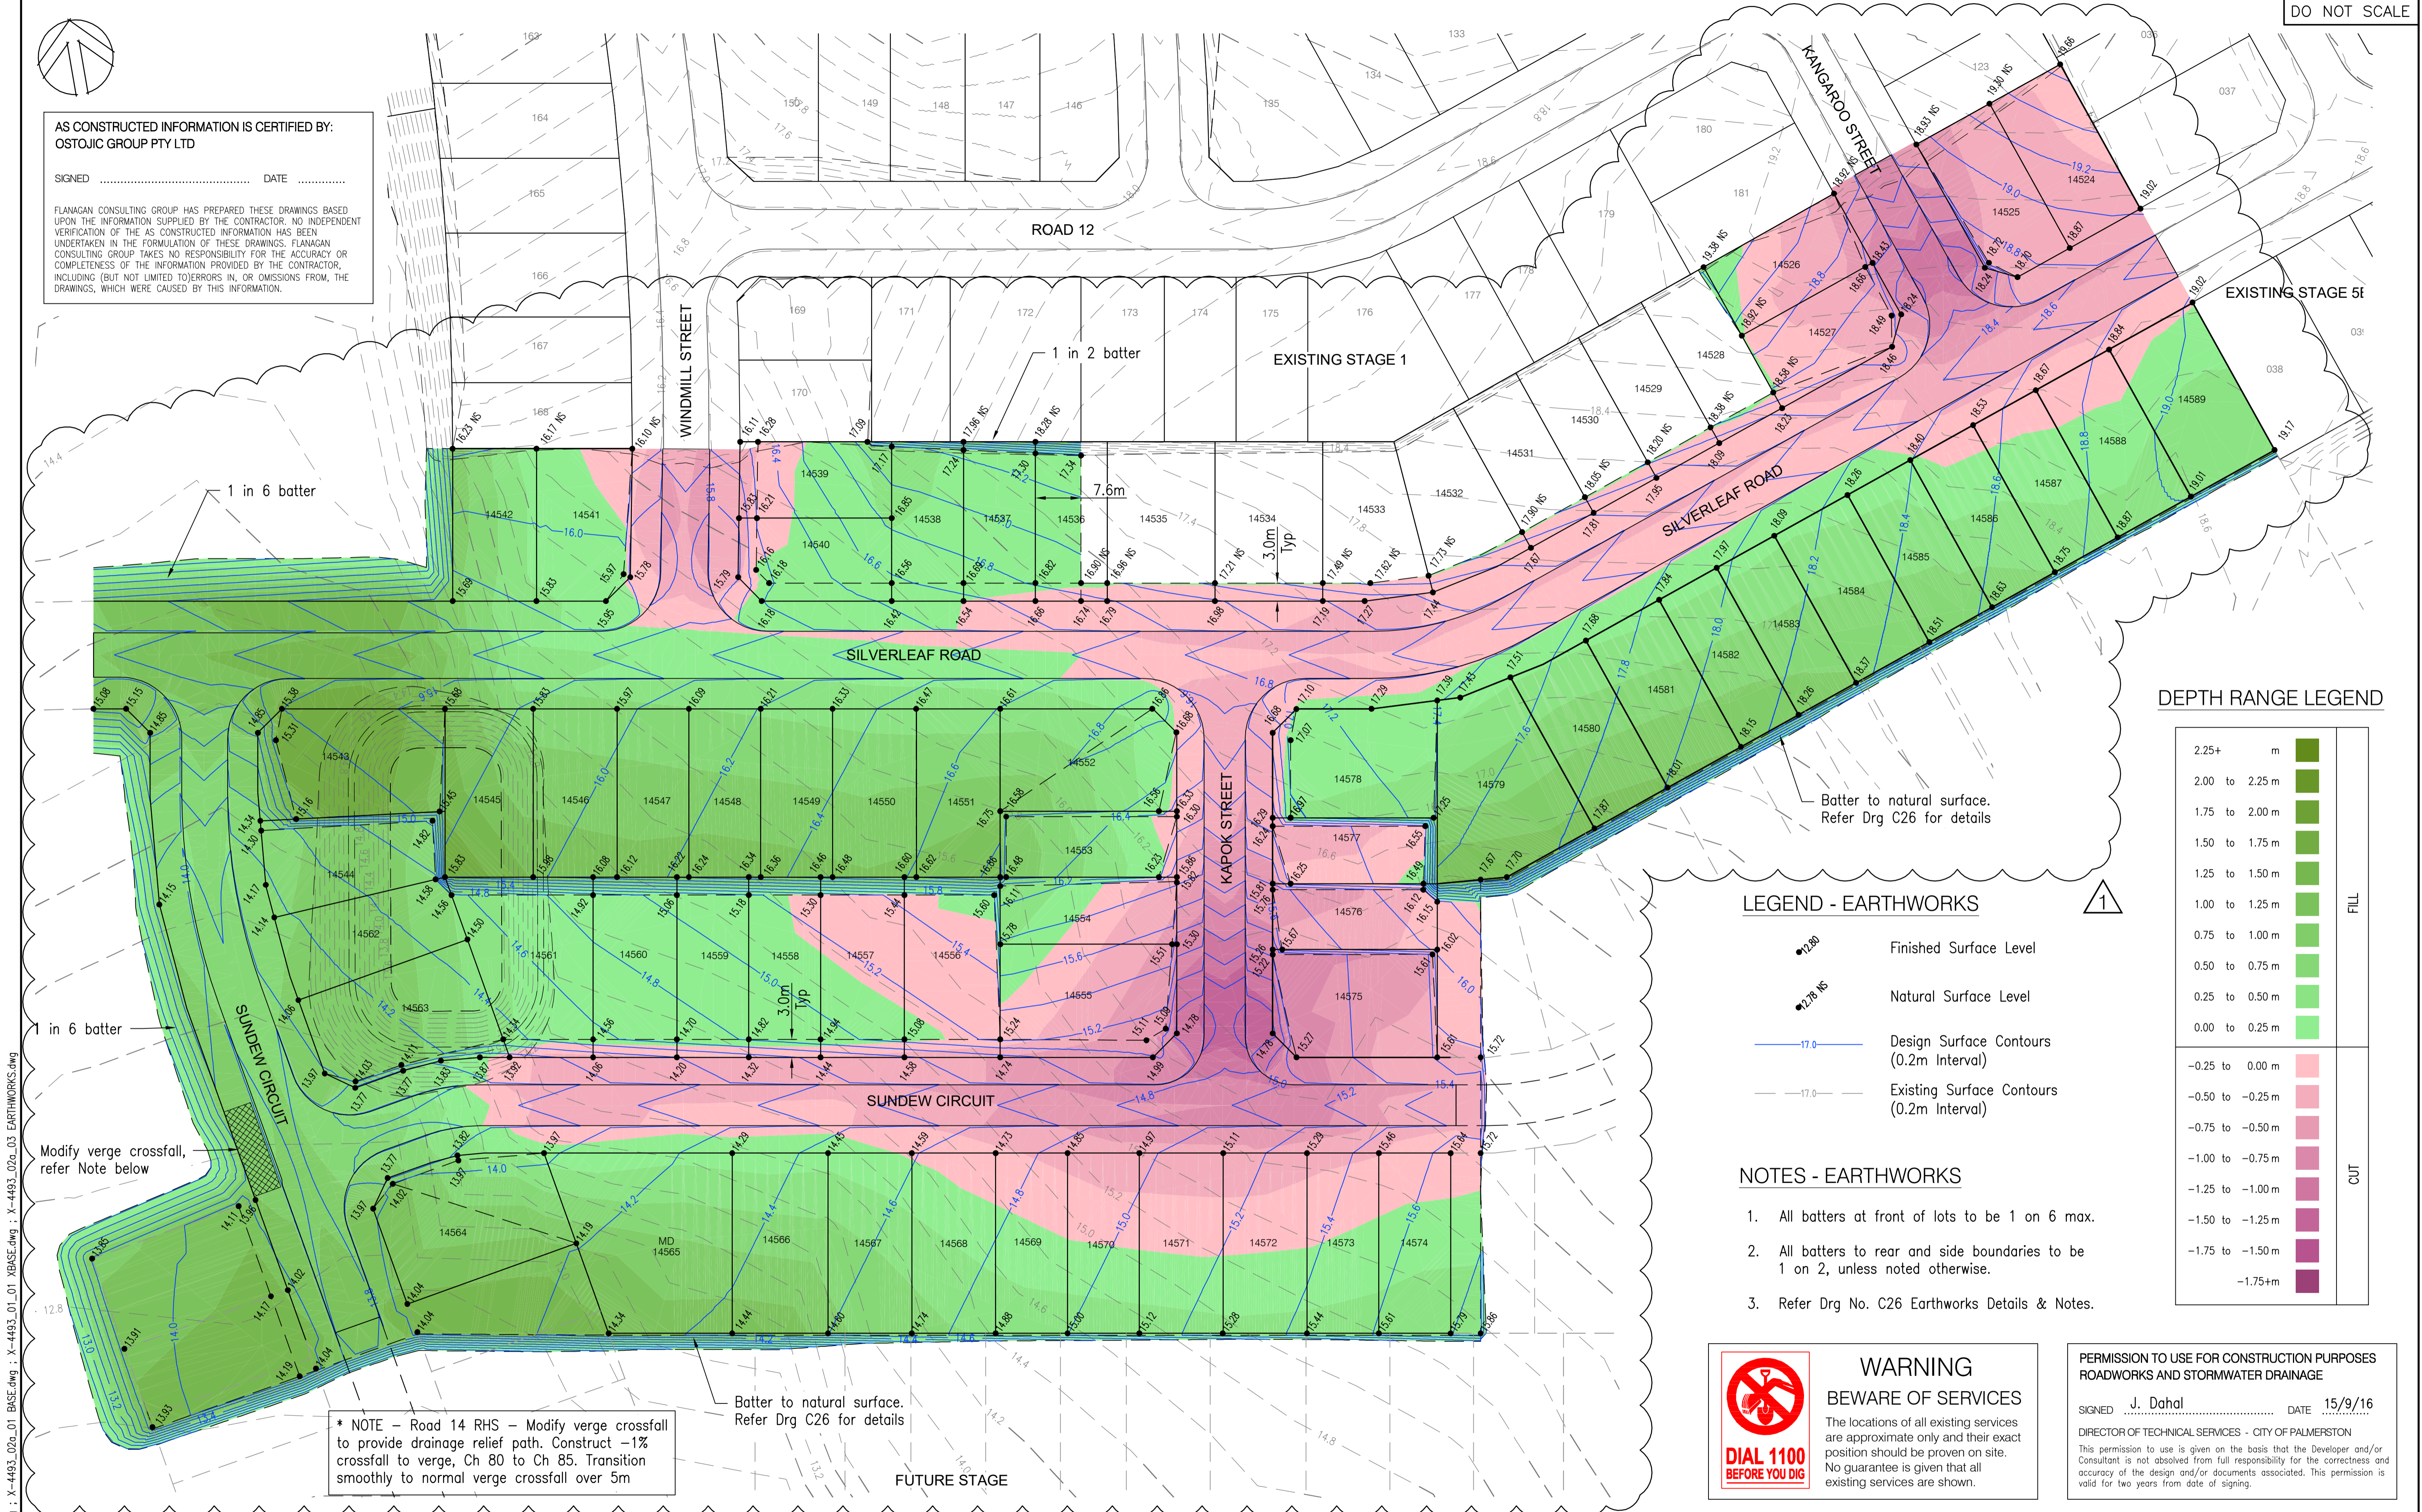

#### DEPTH RANGE LEGEND

2.25+ m	FILL
2.00 to 2.25 m	
1.75 to 2.00 m	
1.50 to 1.75 m	
1.25 to 1.50 m	
1.00 to 1.25 m	
0.75 to 1.00 m	
0.50 to 0.75 m	
0.25 to 0.50 m	
0.00 to 0.25 m	
-0.25 to 0.00 m	CUT
-0.50 to -0.25 m	
-0.75 to -0.50 m	
-1.00 to -0.75 m	
-1.25 to -1.00 m	
-1.50 to -1.25 m	
-1.75 to -1.50 m	
-1.75+m	

#### LEGEND - EARTHWORKS

- 12.80 Finished Surface Level
- 12.78 NS Natural Surface Level
- 17.0 — Design Surface Contours (0.2m Interval)
- 17.0 — Existing Surface Contours (0.2m Interval)

#### NOTES - EARTHWORKS

- All batters at front of lots to be 1 on 6 max.
- All batters to rear and side boundaries to be 1 on 2, unless noted otherwise.
- Refer Drg No. C26 Earthworks Details & Notes.



#### WARNING

##### BEWARE OF SERVICES

The locations of all existing services are approximate only and their exact position should be proven on site. No guarantee is given that all existing services are shown.

#### PERMISSION TO USE FOR CONSTRUCTION PURPOSES ROADWORKS AND STORMWATER DRAINAGE

SIGNED J. Dahal DATE 15/9/16

DIRECTOR OF TECHNICAL SERVICES - CITY OF PALMERSTON

This permission to use is given on the basis that the Developer and/or Consultant is not absolved from full responsibility for the correctness and accuracy of the design and/or documents associated. This permission is valid for two years from date of signing.

REV	DESCRIPTION	TASK MAN.	APPROVED	DATE
1	AS CONSTRUCTED	LM	LM	21/7/17
0	ISSUED FOR CONSTRUCTION	LM	LM	15/9/16

THIS DRAWING IS COPYRIGHT AND THE PROPERTY OF FLANAGAN CONSULTING GROUP, A REGISTERED BUSINESS NAME OF SOUTH PACIFICSANDS PTY. LTD. (ACN 052 933 687) AND MUST NOT BE REPRODUCED WITHOUT WRITTEN PERMISSION.

ASSOCIATED CONSULTANTS

CLIENT / PROJECT
 COSTOJIC Pty Ltd Stage 2A - Civilworks

FLANAGAN CONSULTING GROUP
DEVELOPMENT CONSULTANTS • PROJECT MANAGERS • ENGINEERS • PLANNERS
CAIRNS (07) 4031 3199 DARWIN (08) 8943 0620 MACKAY (07) 4944 1200 TOWNSVILLE (07) 4724 5737 www.flanaganconsulting.com.au

DESIGNED	GJB	TITLE	EARTHWORKS PLAN
DRAWN	GJB		
ACAD No.	4493-34-2-C25		
SCALE	1:500		
		DRAWING No.	4493-34-2-C25
		REVISION	1