


AS CONSTRUCTED



- Stormwater Drainage
- Stormwater Property Connections
- Water Reticulation
- Sewerage Reticulation
- Electrical
- Street Light
- Electrical Pillar
- Electrical Substation
- Proposed Driveway Location
- Irrigation Conduit
- W/E Water over Electrical
- W/D Water over Drainage
- W/S Water over Sewer
- D/E Drainage over Electrical
- D/S Drainage over Sewer
- D/W Drainage over Water
- E/S Electrical over Sewer

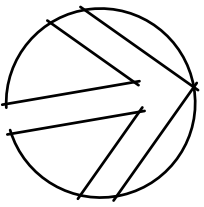

WARNING
BEWARE OF SERVICES
The locations of all existing services are approximate only and their exact position should be proven on site. No guarantee is given that all existing services are shown.


PERMISSION TO USE FOR CONSTRUCTION PURPOSES
SIGNED **D. Buentipo** DATE **12/01/17**
ON BEHALF OF WATER SERVICES FOR THE INCORPORATION INTO POWER AND WATER CORPORATION'S NETWORK
This permission to use is given on the basis that the Developer and/or Consultant is not absolved from full responsibility for the correctness and accuracy of the design and/or documents associated. This permission is valid for two years from date of signing.

DESIGN CERTIFICATION
CERTIFIER'S NAME: **LUKE MUIR**
PWC ACCREDITATION CODE: **DESCRTBL 38**
DATE: **24/01/17** SIGNATURE:

AS CONSTRUCTED INFORMATION IS CERTIFIED BY:
OSTOJIC GROUP PTY LTD
SIGNED DATE
FLANAGAN CONSULTING GROUP HAS PREPARED THESE DRAWINGS BASED UPON THE INFORMATION SUPPLIED BY THE CONTRACTOR. NO INDEPENDENT VERIFICATION OF THE AS CONSTRUCTED INFORMATION HAS BEEN UNDERTAKEN IN THE FORMULATION OF THESE DRAWINGS. FLANAGAN CONSULTING GROUP TAKES NO RESPONSIBILITY FOR THE ACCURACY OR COMPLETENESS OF THE INFORMATION PROVIDED BY THE CONTRACTOR, INCLUDING (BUT NOT LIMITED TO) ERRORS IN, OR OMISSIONS FROM, THE DRAWINGS, WHICH WERE CAUSED BY THIS INFORMATION.

NOTES

1. Refer Drainage, Water & Sewer Plans for details of service crossings and setout information.

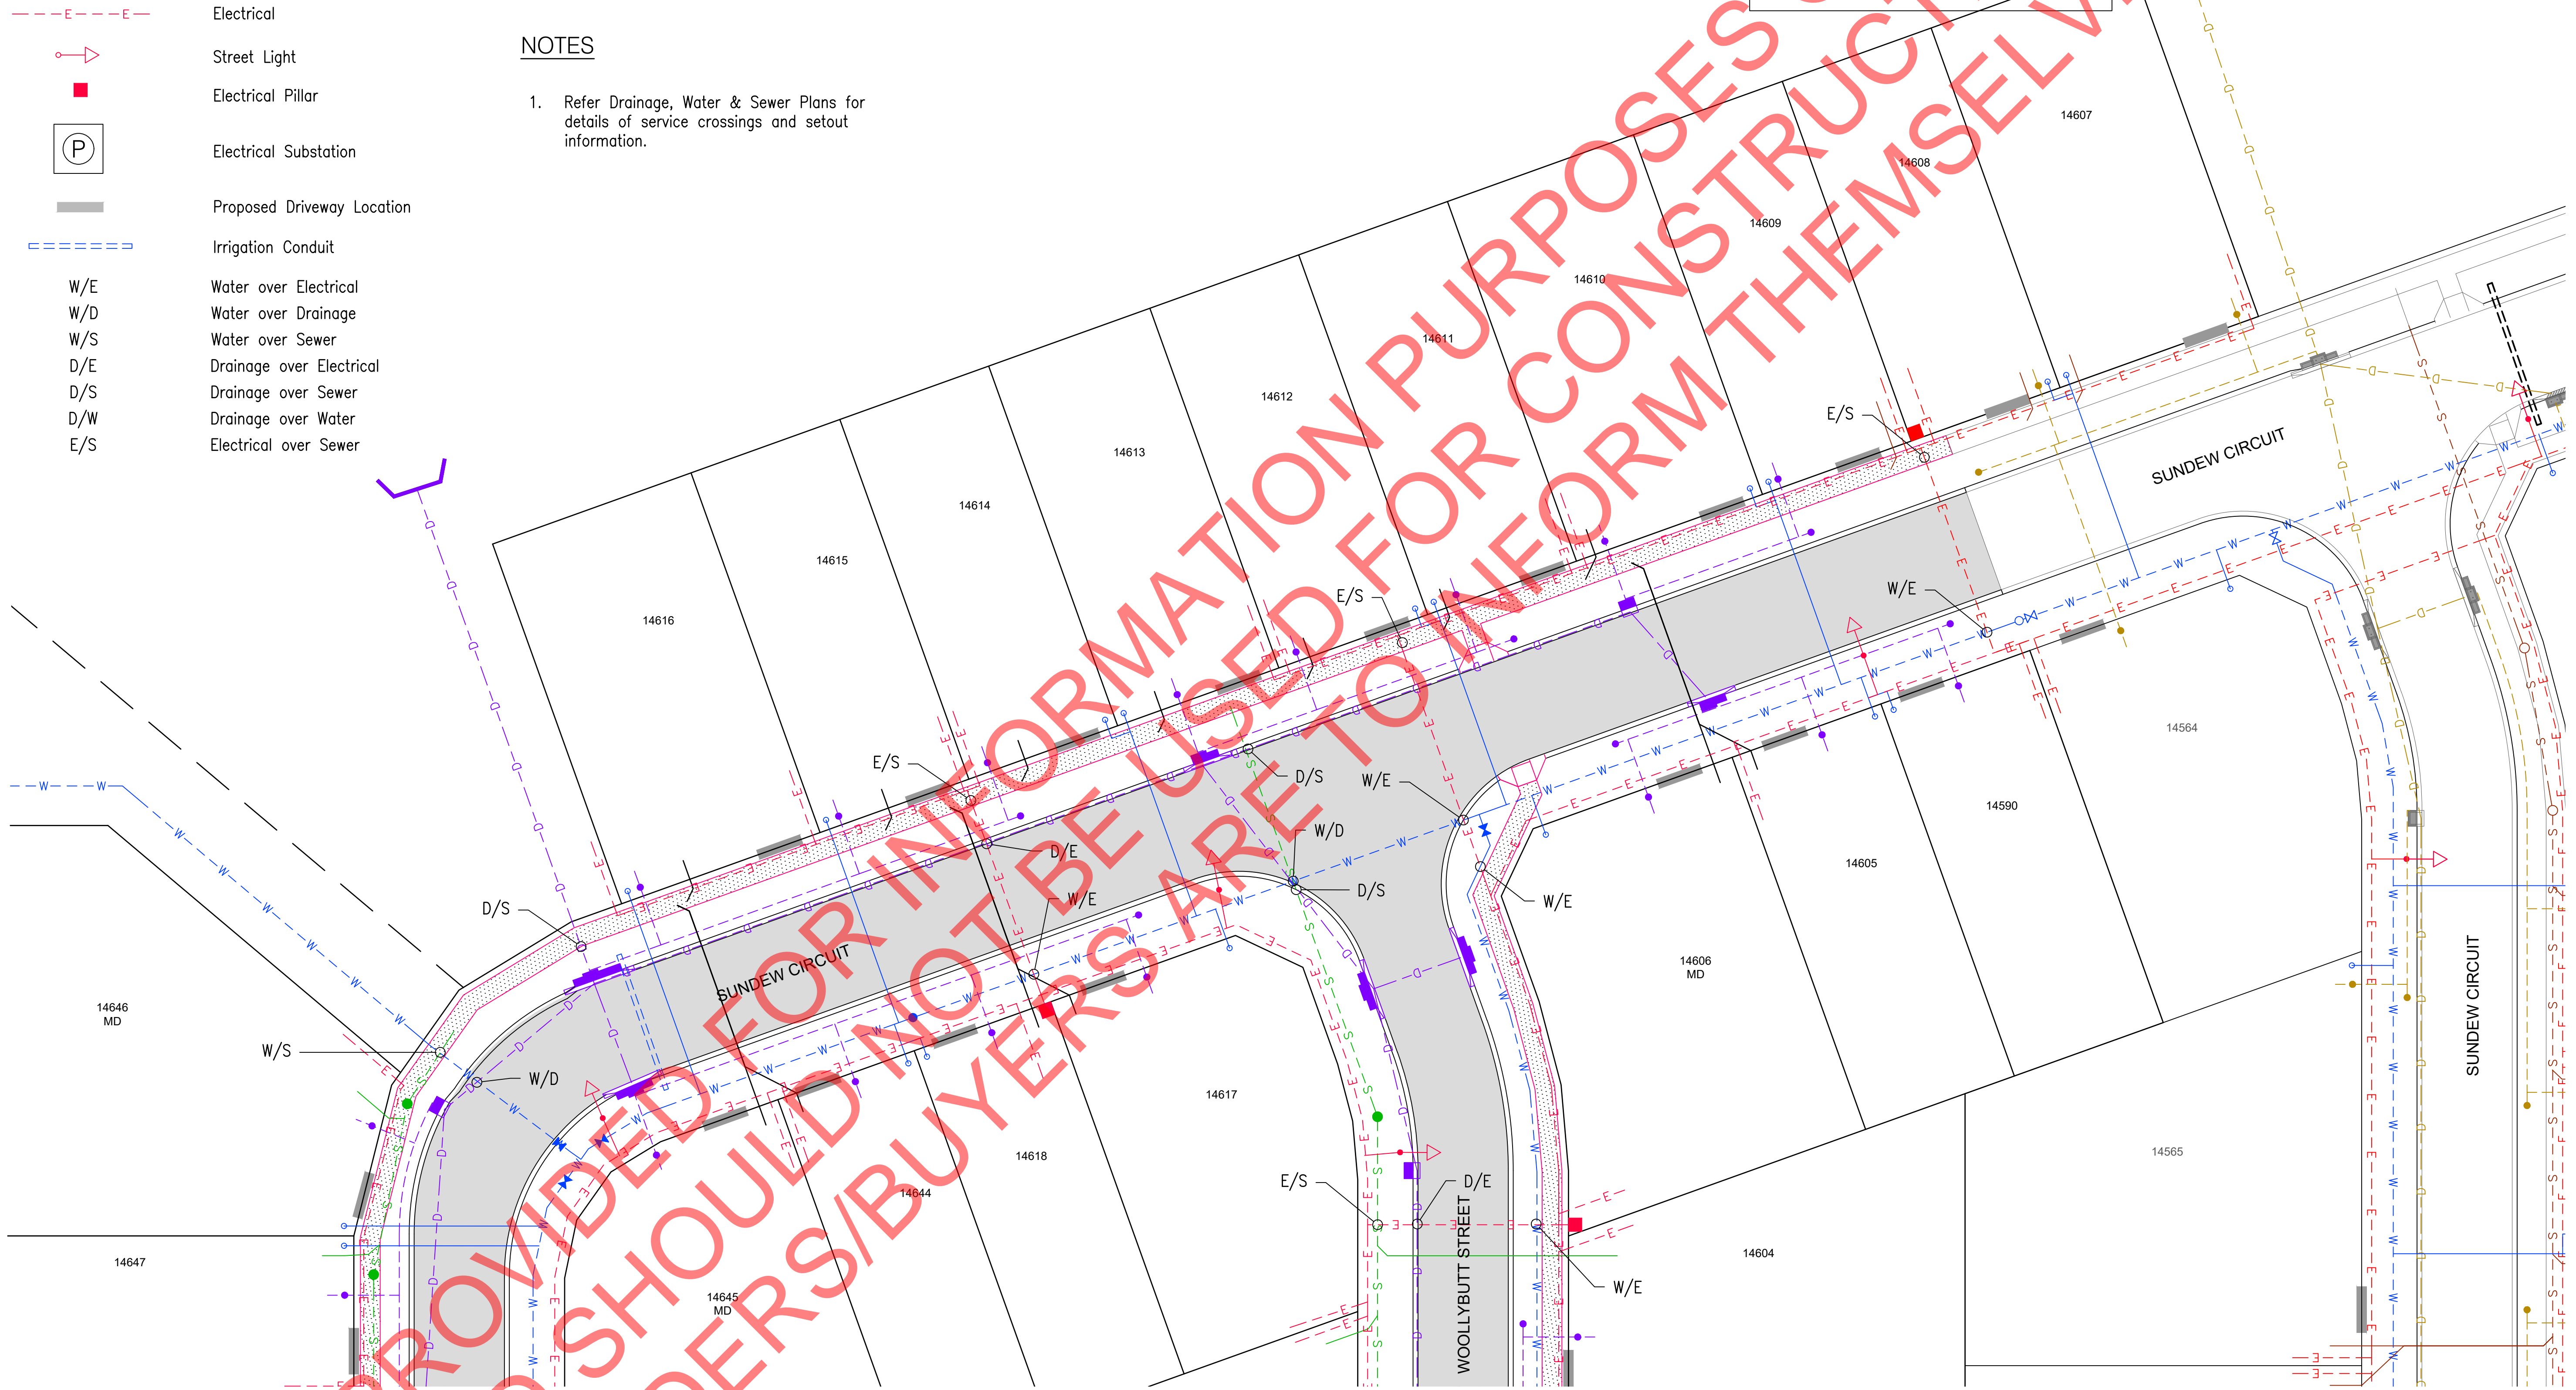

For Continuation Refer Drg C114 (PWC Drg No B16-11488)

REV	DESCRIPTION	TASK MAN.	APPROVED	DATE
3	AS CONSTRUCTED - COMPLETE	MR	RB	23/01/18
2	AS CONSTRUCTED - STAGE 2c	MR	RB	09/11/17
1	LOT NUMBERS AND STREET NAMES ADDED	LM	LM	31/01/17
0	ISSUED FOR CONSTRUCTION	LM	LM	24/01/17

THIS DRAWING IS COPYRIGHT AND THE PROPERTY OF FLANAGAN CONSULTING GROUP, A REGISTERED BUSINESS NAME OF SOUTH PACIFICSANDS PTY. LTD. (ACN 052 933 687) AND MUST NOT BE REPRODUCED WITHOUT WRITTEN PERMISSION.

ASSOCIATED CONSULTANTS

CLIENT / PROJECT



COSTOJIC Pty Ltd
Stages 2B & 2C
Civilworks



DEVELOPMENT CONSULTANTS • PROJECT MANAGERS • ENGINEERS • PLANNERS
CAIRNS (07) 4031 3199 DARWIN (08) 8943 0620 MACKAY (07) 4944 1200 TOWNSVILLE (07) 4724 5737
www.flanaganconsulting.com.au

DESIGNED	GJB
DRAWN	GJB
ACAD No.	4493-34-2-C113
SCALE	1:250

TITLE	MASTER SERVICES PLAN SHEET 1 OF 5
DRAWING No.	4493-34-2-C113
PWC DRG No.	B16-11487
REVISION	3

AS CONSTRUCTED

LEGEND

- Stormwater Drainage
- Stormwater Property Connections
- Water Reticulation
- Sewerage Reticulation
- Electrical
- Street Light
- Electrical Pillar
- Electrical Substation
- Proposed Driveway Location
- Irrigation Conduit
- W/E Water over Electrical
- W/D Water over Drainage
- W/S Water over Sewer
- D/E Drainage over Electrical
- D/S Drainage over Sewer
- D/W Drainage over Water
- E/S Electrical over Sewer

NOTES

- Refer Drainage, Water & Sewer Plans for details of service crossings and setout information.

AS CONSTRUCTED INFORMATION IS CERTIFIED BY:
OSTOJIC GROUP PTY LTD

SIGNED DATE

FLANAGAN CONSULTING GROUP HAS PREPARED THESE DRAWINGS BASED UPON THE INFORMATION SUPPLIED BY THE CONTRACTOR. NO INDEPENDENT VERIFICATION OF THE AS CONSTRUCTED INFORMATION HAS BEEN UNDERTAKEN IN THE FORMULATION OF THESE DRAWINGS. FLANAGAN CONSULTING GROUP TAKES NO RESPONSIBILITY FOR THE ACCURACY OR COMPLETENESS OF THE INFORMATION PROVIDED BY THE CONTRACTOR, INCLUDING (BUT NOT LIMITED TO) ERRORS IN, OR OMISSIONS FROM, THE DRAWINGS, WHICH WERE CAUSED BY THIS INFORMATION.



WARNING
BEWARE OF SERVICES

The locations of all existing services are approximate only and their exact position should be proven on site. No guarantee is given that all existing services are shown.

PERMISSION TO USE FOR CONSTRUCTION PURPOSES

SIGNED D. Buentipo DATE 12/01/17

ON BEHALF OF WATER SERVICES FOR THE INCORPORATION INTO POWER AND WATER CORPORATION'S NETWORK

This permission to use is given on the basis that the Developer and/or Consultant is not absolved from full responsibility for the correctness and accuracy of the design and/or documents associated. This permission is valid for two years from date of signing.

DESIGN CERTIFICATION

CERTIFIER'S NAME: LUKE MUIR
PWC ACCREDITATION CODE: DESCRTBL 38
DATE: 24/01/17 SIGNATURE:


For Continuation Refer Drg C113 (PWC Drg No B16-11487)

For Continuation Refer Drg C115 (PWC Drg No B16-11489)

REV	DESCRIPTION	TASK MAN.	APPROVED	DATE
3	AS CONSTRUCTED - COMPLETE	MR	RB	23/01/18
2	AS CONSTRUCTED - STAGE 2c	MR	RB	09/11/17
1	LOT NUMBERS AND STREET NAMES ADDED	LM	LM	31/01/17
0	ISSUED FOR CONSTRUCTION	LM	LM	24/01/17

THIS DRAWING IS COPYRIGHT AND THE PROPERTY OF FLANAGAN CONSULTING GROUP, A REGISTERED BUSINESS NAME OF SOUTH PACIFICSANDS PTY. LTD. (ACN 052 933 687) AND MUST NOT BE REPRODUCED WITHOUT WRITTEN PERMISSION.

ASSOCIATED CONSULTANTS

CLIENT / PROJECT
 COSTOJIC Pty Ltd Stages 2B & 2C Civilworks

FLANAGAN CONSULTING GROUP
DEVELOPMENT CONSULTANTS • PROJECT MANAGERS • ENGINEERS • PLANNERS
CAIRNS (07) 4031 3199 DARWIN (08) 8943 0620 MACKAY (07) 4944 1200 TOWNSVILLE (07) 4724 5737
www.flanaganconsulting.com.au

DESIGNED
GJB
DRAWN
GJB
ACAD No.
4493-34-2-C114
SCALE
1:250

TITLE
MASTER SERVICES PLAN SHEET 2 OF 5
DRAWING No.
4493-34-2-C114
PWC DRG No.
B16-11488
REVISION
3

For Continuation Refer Drg C114 (PWC Drg No B16-11488)

AS CONSTRUCTED

LEGEND

- Stormwater Drainage
- Stormwater Property Connections
- Water Reticulation
- Sewerage Reticulation
- Electrical
- Street Light
- Electrical Pillar
- Electrical Substation
- Proposed Driveway Location
- Irrigation Conduit
- W/E Water over Electrical
- W/D Water over Drainage
- W/S Water over Sewer
- D/E Drainage over Electrical
- D/S Drainage over Sewer
- D/W Drainage over Water
- E/S Electrical over Sewer

NOTES

- Refer Drainage, Water & Sewer Plans for details of service crossings and setout information.

AS CONSTRUCTED INFORMATION IS CERTIFIED BY:
OSTOJIC GROUP PTY LTD

SIGNED DATE

FLANAGAN CONSULTING GROUP HAS PREPARED THESE DRAWINGS BASED UPON THE INFORMATION SUPPLIED BY THE CONTRACTOR. NO INDEPENDENT VERIFICATION OF THE AS CONSTRUCTED INFORMATION HAS BEEN UNDERTAKEN IN THE FORMULATION OF THESE DRAWINGS. FLANAGAN CONSULTING GROUP TAKES NO RESPONSIBILITY FOR THE ACCURACY OR COMPLETENESS OF THE INFORMATION PROVIDED BY THE CONTRACTOR, INCLUDING (BUT NOT LIMITED TO) ERRORS IN, OR OMISSIONS FROM, THE DRAWINGS, WHICH WERE CAUSED BY THIS INFORMATION.



WARNING
BEWARE OF SERVICES

The locations of all existing services are approximate only and their exact position should be proven on site. No guarantee is given that all existing services are shown.

PERMISSION TO USE FOR CONSTRUCTION PURPOSES

SIGNED D. Buentipo DATE 12/01/17

ON BEHALF OF WATER SERVICES FOR THE INCORPORATION INTO POWER AND WATER CORPORATIONS NETWORK

This permission to use is given on the basis that the Developer and/or Consultant is not absolved from full responsibility for the correctness and accuracy of the design and/or documents associated. This permission is valid for two years from date of signing.

DESIGN CERTIFICATION

CERTIFIER'S NAME: LUKE MUIR
PWC ACCREDITATION CODE: DESCERTBL 38
DATE: 24/01/17 SIGNATURE:



For Continuation Refer Drg C116 (PWC Drg No B16-11490)

REV	DESCRIPTION	TASK MAN.	APPROVED	DATE
4	AS CONSTRUCTED - COMPLETE	MR	RB	23/01/18
3	AS CONSTRUCTED - STAGE 2c	MR	RB	09/11/17
2	SEWER & DRAINAGE CONNECTION ADDED - LOT 265	LM	LM	02/05/17
1	LOT NUMBERS AND STREET NAMES ADDED	LM	LM	31/01/17
0	ISSUED FOR CONSTRUCTION	LM	LM	24/01/17


THIS DRAWING IS COPYRIGHT AND THE PROPERTY OF FLANAGAN CONSULTING GROUP, A REGISTERED BUSINESS NAME OF SOUTH PACIFICSANDS PTY. LTD. (ACN 052 933 687) AND MUST NOT BE REPRODUCED WITHOUT WRITTEN PERMISSION.

ASSOCIATED CONSULTANTS

CLIENT / PROJECT




COSTOJIC Pty Ltd
Stages 2B & 2C
Civilworks

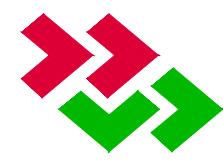

FLANAGAN CONSULTING GROUP
DEVELOPMENT CONSULTANTS • PROJECT MANAGERS • ENGINEERS • PLANNERS
CAIRNS (07) 4031 3199 DARWIN (08) 8943 0620 MACKAY (07) 4944 1200 TOWNSVILLE (07) 4724 5737
www.flanaganconsulting.com.au

DESIGNED	GJB
DRAWN	GJB
ACAD No.	4493-34-2-C115
SCALE	1:250

TITLE	MASTER SERVICES PLAN SHEET 3 OF 5
DRAWING No.	4493-34-2-C115
PWC DRG No.	B16-11489
REVISION	4

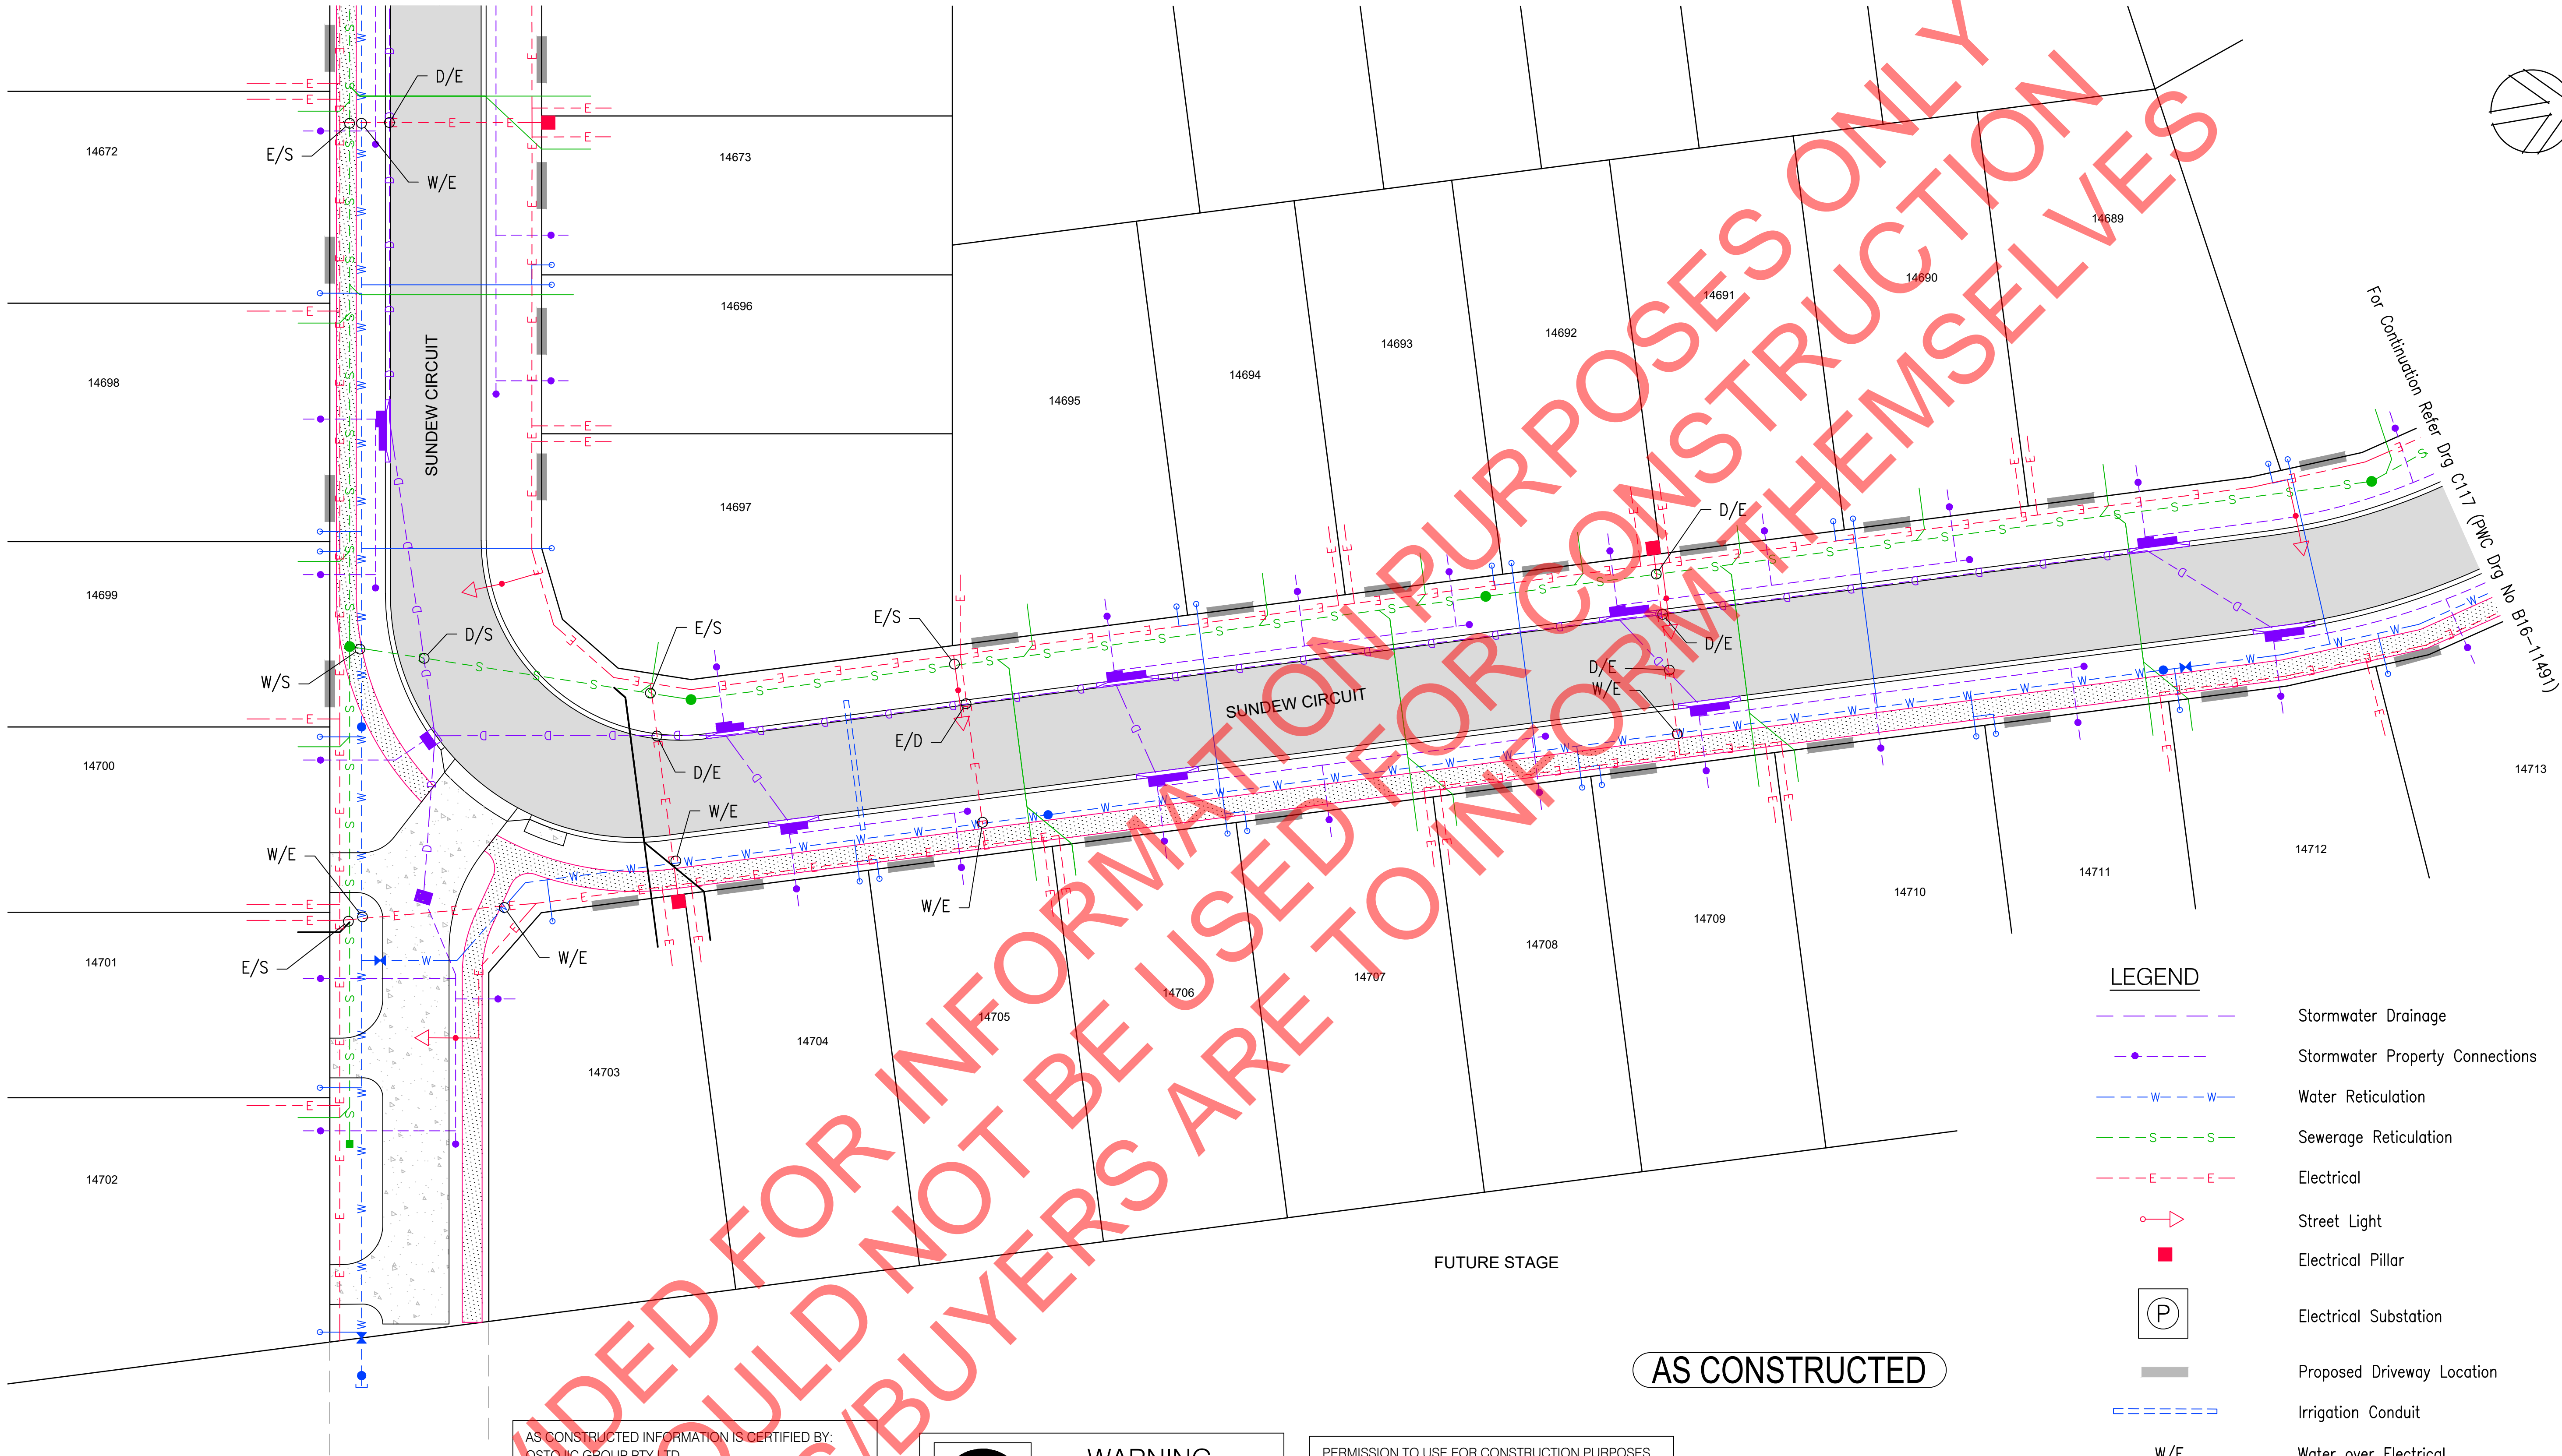

NOTES

1. Refer Drainage, Water & Sewer Plans for details of service crossings and setout information.

AS CONSTRUCTED INFORMATION IS CERTIFIED BY:
OSTOJIC GROUP PTY LTD

SIGNED DATE

FLANAGAN CONSULTING GROUP HAS PREPARED THESE DRAWINGS BASED UPON THE INFORMATION SUPPLIED BY THE CONTRACTOR. NO INDEPENDENT VERIFICATION OF THE AS CONSTRUCTED INFORMATION HAS BEEN UNDERTAKEN IN THE FORMULATION OF THESE DRAWINGS. FLANAGAN CONSULTING GROUP TAKES NO RESPONSIBILITY FOR THE ACCURACY OR COMPLETENESS OF THE INFORMATION PROVIDED BY THE CONTRACTOR, INCLUDING (BUT NOT LIMITED TO) ERRORS IN, OR OMISSIONS FROM, THE DRAWINGS, WHICH WERE CAUSED BY THIS INFORMATION.



WARNING
BEWARE OF SERVICES

The locations of all existing services are approximate only and their exact position should be proven on site. No guarantee is given that all existing services are shown.

PERMISSION TO USE FOR CONSTRUCTION PURPOSES

SIGNED D. Buentipio DATE 12/01/17

ON BEHALF OF WATER SERVICES FOR THE INCORPORATION INTO POWER AND WATER CORPORATION'S NETWORK

This permission to use is given on the basis that the Developer and/or Consultant is not absolved from full responsibility for the correctness and accuracy of the design and/or documents associated. This permission is valid for two years from date of signing.

DESIGN CERTIFICATION

CERTIFIER'S NAME: LUKE MUIR

PWC ACCREDITATION CODE: DESCERTBL 38

DATE: 24/01/17 SIGNATURE:

REV	DESCRIPTION	TASK MAN.	APPROVED	DATE
3	AS CONSTRUCTED - COMPLETE	MR	RB	23/01/18
2	AS CONSTRUCTED - STAGE 2c	MR	RB	09/11/17
1	LOT NUMBERS AND STREET NAMES ADDED	LM	LM	31/01/17
0	ISSUED FOR CONSTRUCTION	LM	LM	24/01/17


THIS DRAWING IS COPYRIGHT AND THE PROPERTY OF FLANAGAN CONSULTING GROUP, A REGISTERED BUSINESS NAME OF SOUTH PACIFICSANDS PTY. LTD. (ACN 052 933 687) AND MUST NOT BE REPRODUCED WITHOUT WRITTEN PERMISSION.

ASSOCIATED CONSULTANTS			

CLIENT / PROJECT	
	COSTOJIC Pty Ltd Stages 2B & 2C Civilworks

	DEVELOPMENT CONSULTANTS • PROJECT MANAGERS • ENGINEERS • PLANNERS
CAIRNS (07) 4031 3199	DARWIN (08) 8943 0620
MACKAY (07) 4944 1200	TOWNSVILLE (07) 4724 5737
www.flanaganconsulting.com.au	

DESIGNED	GJB	TITLE MASTER SERVICES PLAN SHEET 4 OF 5			
DRAWN	GJB				
ACAD No.	4493-34-2-C116	A1 FULL SIZE	DRAWING No.	4493-34-2-C116	REVISION
SCALE	1:250		PWC DRG No. B16-11490	3	

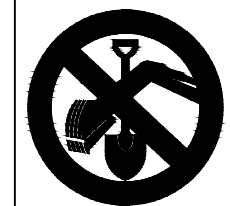

WARNING
BEWARE OF SERVICES
The locations of all existing services are approximate only and their exact position should be proven on site. No guarantee is given that all existing services are shown.

AS CONSTRUCTED INFORMATION IS CERTIFIED BY:
OSTOJIC GROUP PTY LTD

SIGNED DATE

FLANAGAN CONSULTING GROUP HAS PREPARED THESE DRAWINGS BASED UPON THE INFORMATION SUPPLIED BY THE CONTRACTOR. NO INDEPENDENT VERIFICATION OF THE AS CONSTRUCTED INFORMATION HAS BEEN UNDERTAKEN IN THE FORMULATION OF THESE DRAWINGS. FLANAGAN CONSULTING GROUP TAKES NO RESPONSIBILITY FOR THE ACCURACY OR COMPLETENESS OF THE INFORMATION PROVIDED BY THE CONTRACTOR, INCLUDING (BUT NOT LIMITED TO) ERRORS IN, OR OMISSIONS FROM, THE DRAWINGS, WHICH WERE CAUSED BY THIS INFORMATION.


AS CONSTRUCTED

DESIGN CERTIFICATION

CERTIFIER'S NAME: LUKE MUIR
PWC ACCREDITATION CODE: DESCERTBL 38
DATE: 24/01/17 SIGNATURE:

PERMISSION TO USE FOR CONSTRUCTION PURPOSES

SIGNED D. Buentipo DATE 12/01/17
ON BEHALF OF WATER SERVICES FOR THE INCORPORATION INTO POWER AND WATER CORPORATION'S NETWORK
This permission to use is given on the basis that the Developer and/or Consultant is not absolved from full responsibility for the correctness and accuracy of the design and/or documents associated. This permission is valid for two years from date of signing.

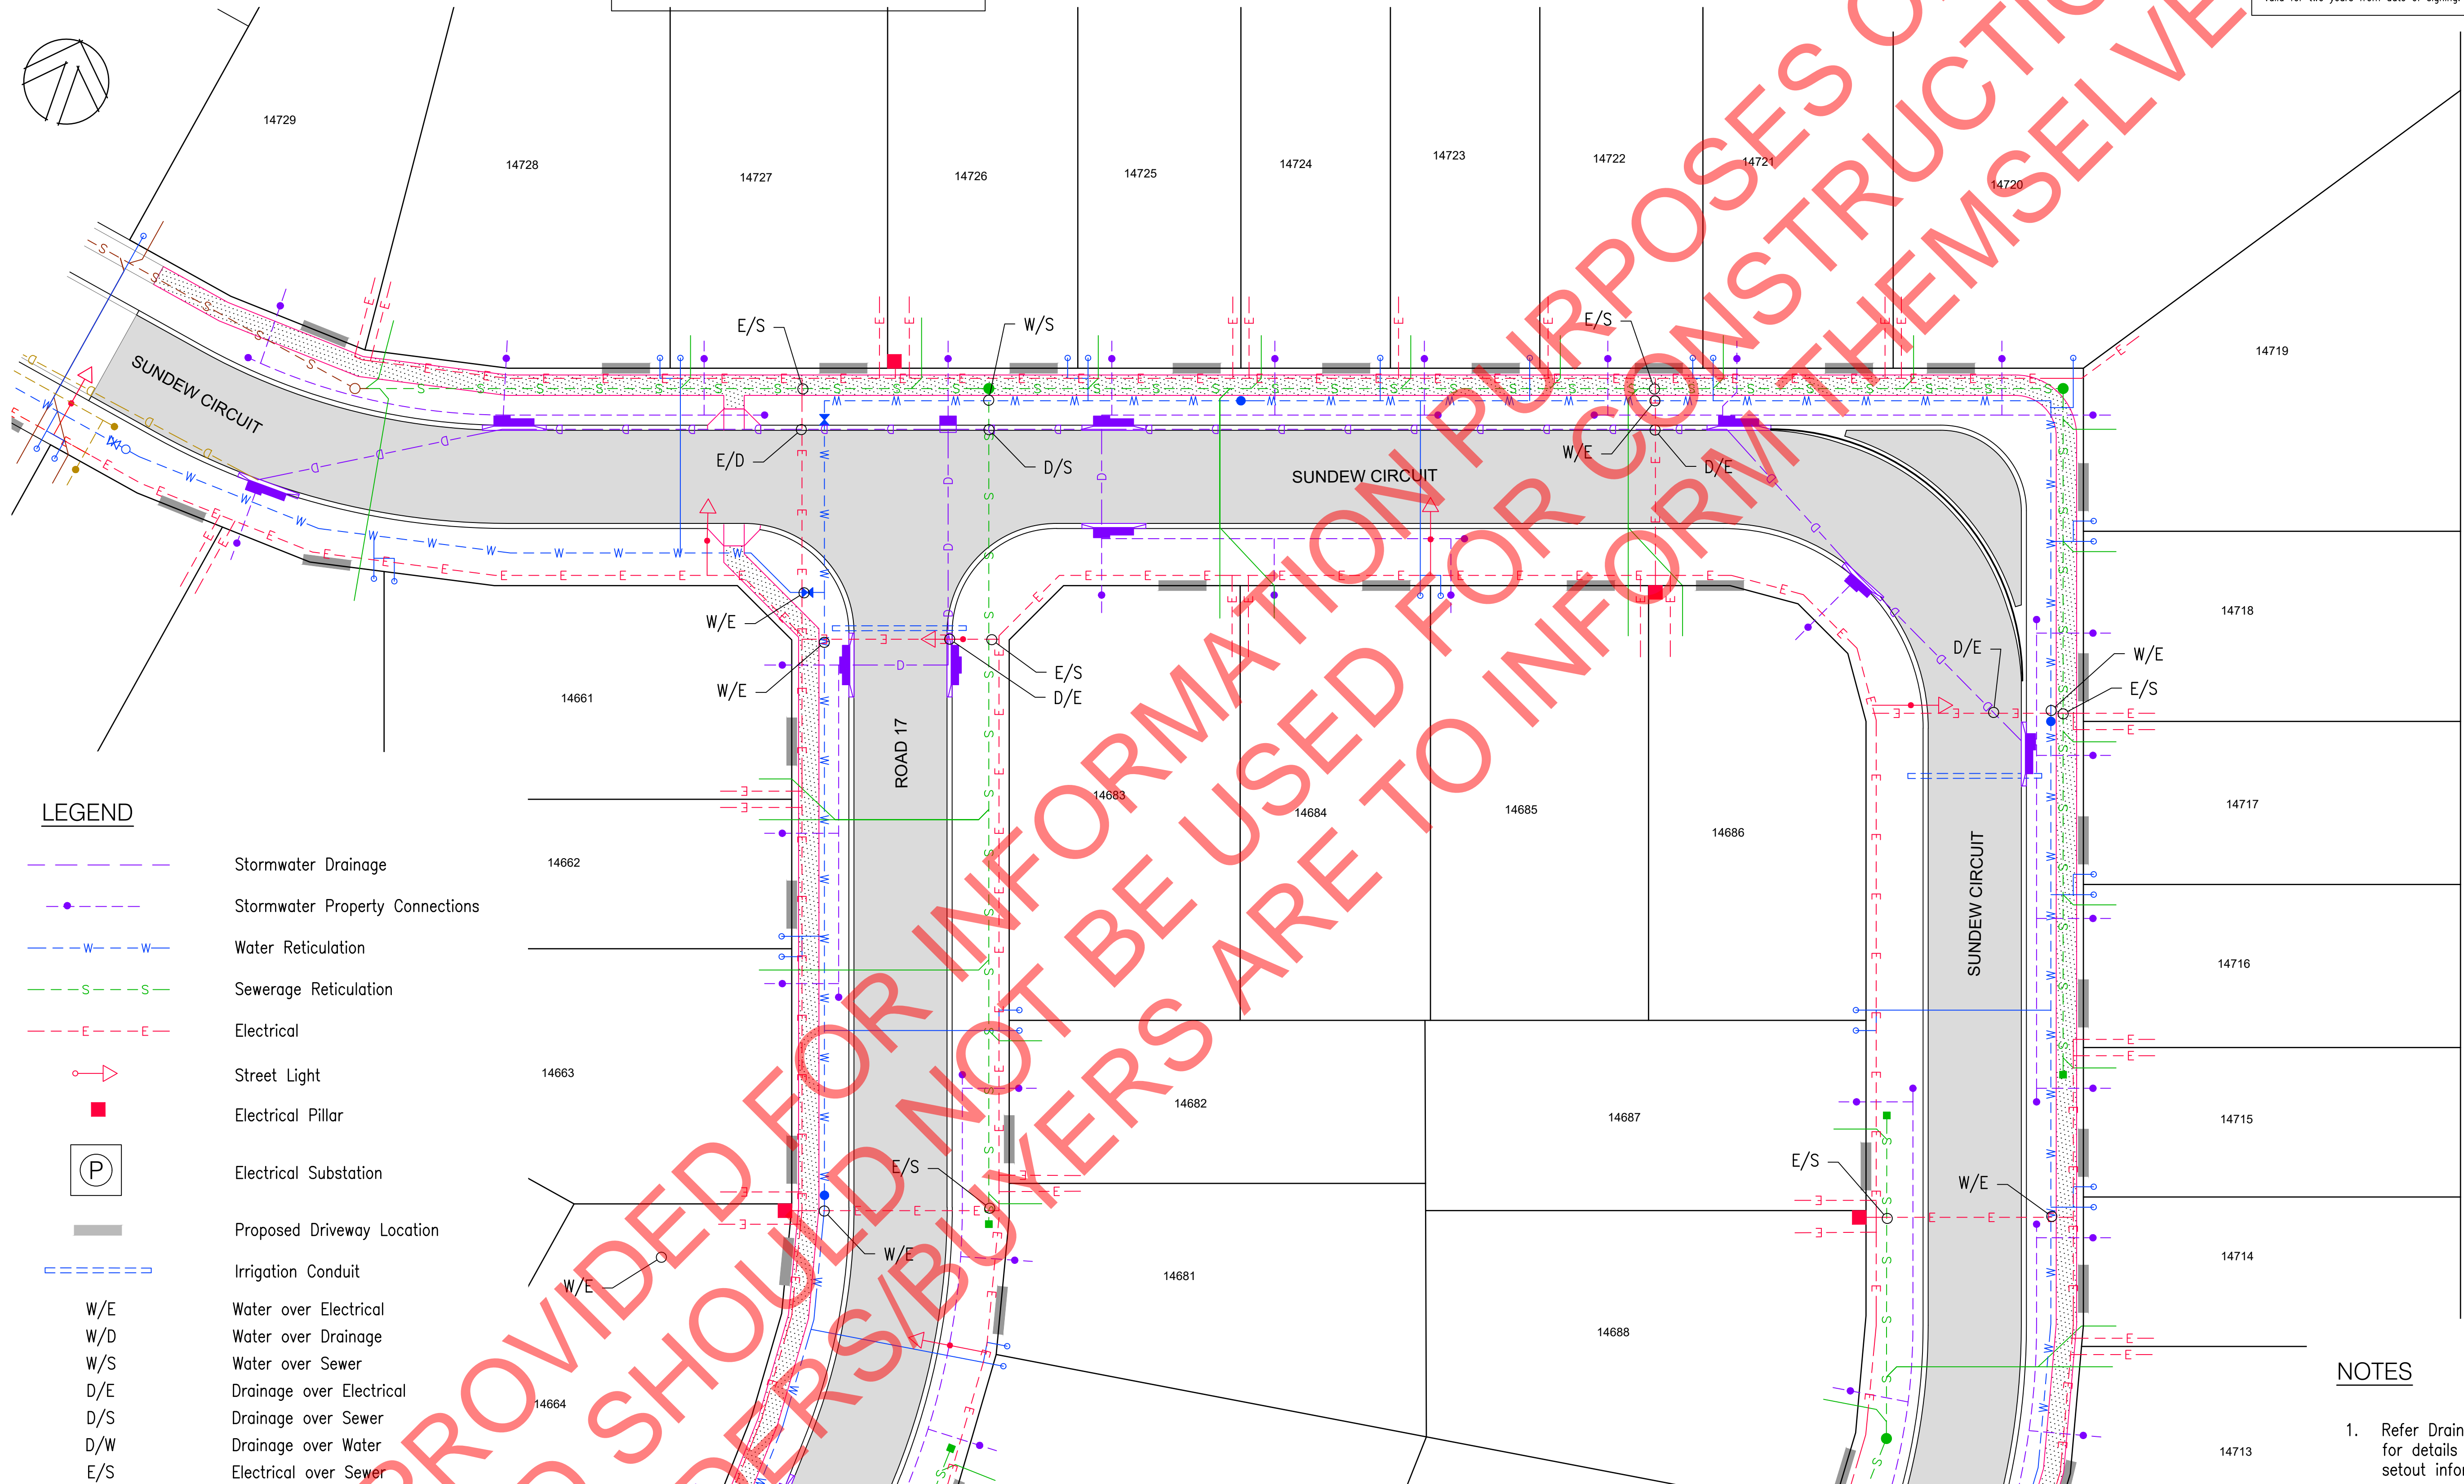

LEGEND

- Stormwater Drainage
- Stormwater Property Connections
- Water Reticulation
- Sewerage Reticulation
- Electrical
- Street Light
- Electrical Pillar
- Electrical Substation
- Proposed Driveway Location
- Irrigation Conduit
- W/E Water over Electrical
- W/D Water over Drainage
- W/S Water over Sewer
- D/E Drainage over Electrical
- D/S Drainage over Sewer
- D/W Drainage over Water
- E/S Electrical over Sewer

NOTES

- Refer Drainage, Water & Sewer Plans for details of service crossings and setout information.

For Continuation Refer Drg C115 (PWC Drg No B16-11489)

For Continuation Refer Drg C116 (PWC Drg No B16-11490)

REV	DESCRIPTION	TASK MAN.	APPROVED	DATE
3	AS CONSTRUCTED - COMPLETE	MR	RB	23/01/18
2	AS CONSTRUCTED - STAGE 2c	MR	RB	09/11/17
1	LOT NUMBERS AND STREET NAMES ADDED	LM	LM	31/01/17
0	ISSUED FOR CONSTRUCTION	LM	LM	24/01/17

THIS DRAWING IS COPYRIGHT AND THE PROPERTY OF FLANAGAN CONSULTING GROUP, A REGISTERED BUSINESS NAME OF SOUTH PACIFICSANDS PTY. LTD. (ACN 052 933 687) AND MUST NOT BE REPRODUCED WITHOUT WRITTEN PERMISSION.

ASSOCIATED CONSULTANTS

CLIENT / PROJECT



COSTOJIC Pty Ltd
Stages 2B & 2C
Civilworks



FLANAGAN CONSULTING GROUP
DEVELOPMENT CONSULTANTS • PROJECT MANAGERS • ENGINEERS • PLANNERS
CAIRNS (07) 4031 3199 DARWIN (08) 8943 0620 MACKAY (07) 4944 1200 TOWNSVILLE (07) 4724 5737
www.flanaganconsulting.com.au

DESIGNED	GJB
DRAWN	GJB
ACAD No.	4493-34-2-C117
SCALE	1:250

TITLE	MASTER SERVICES PLAN SHEET 5 OF 5
DRAWING No.	4493-34-2-C117
REVISION	3
PWC DRG No.	B16-11491