

LEGEND

- STAGE BOUNDARY
- D-D- STORMWATER DRAINAGE
- W-W- WATER RETICULATION
- S-S- SEWERAGE RETICULATION
- E-E- ELECTRICAL
- STREET LIGHT
- DF ELECTRICAL PILLAR
- P ELECTRICAL SUBSTATION
- PROPOSED DRIVEWAY

NOTES

1. REFER DRAINAGE, WATER & SEWER PLANS FOR DETAILS OF SERVICE CROSSINGS AND SETOUT INFORMATION.

DESIGN CERTIFICATION

CERTIFIER'S NAME: CHRISTOPHER MOLL
PWC ACCREDITATION CODE: DESCRTBL28
DATE: 16.10.18 SIGNATURE:



WARNING
BEWARE OF SERVICES

The locations of all existing services are approximate only and their exact position should be proven on site. No guarantee is given that all existing services are shown.

0 5 10 15m
SCALE 1:250
AT ORIGINAL SIZE (A1)

AS CONSTRUCTED

ADG PROJECT 20696 DRG No. B17-6621

NO	DESCRIPTION	DRN	DATE	CKD	APPD
2	AS CONSTRUCTED - ADG	JMB	16.10.18	BL	BL
1	AS CONSTRUCTED - ADG	JMB	15.10.18	SW	CJM
0	ISSUED FOR CONSTRUCTION - FCG	LM	14.07.17	LM	PW
AMENDMENTS					




WARNING
BEWARE OF SERVICES
THE LOCATIONS OF ALL EXISTING SERVICES ARE APPROXIMATE ONLY AND THEIR EXACT POSITION SHOULD BE PROVEN ON SITE. NO GUARANTEE IS GIVEN THAT ALL EXISTING SERVICES ARE SHOWN.



DES	FCG	ZUCCOLI ASPIRE	
DRN	JB	STAGE 3A	
CHK	SW	MASTER SERVICES PLAN	
APPD	CJM	SHEET 1 OF 5	
SCALE	1:250		
ISSUED	16.10.18		
ALL DIM. IN m			
DRAFTING STANDARD TO A.S.1100		CAD PRODUCT - DO NOT AMEND MANUALLY	

A1 DRAWING NUMBER B17-6621

2
AMDT

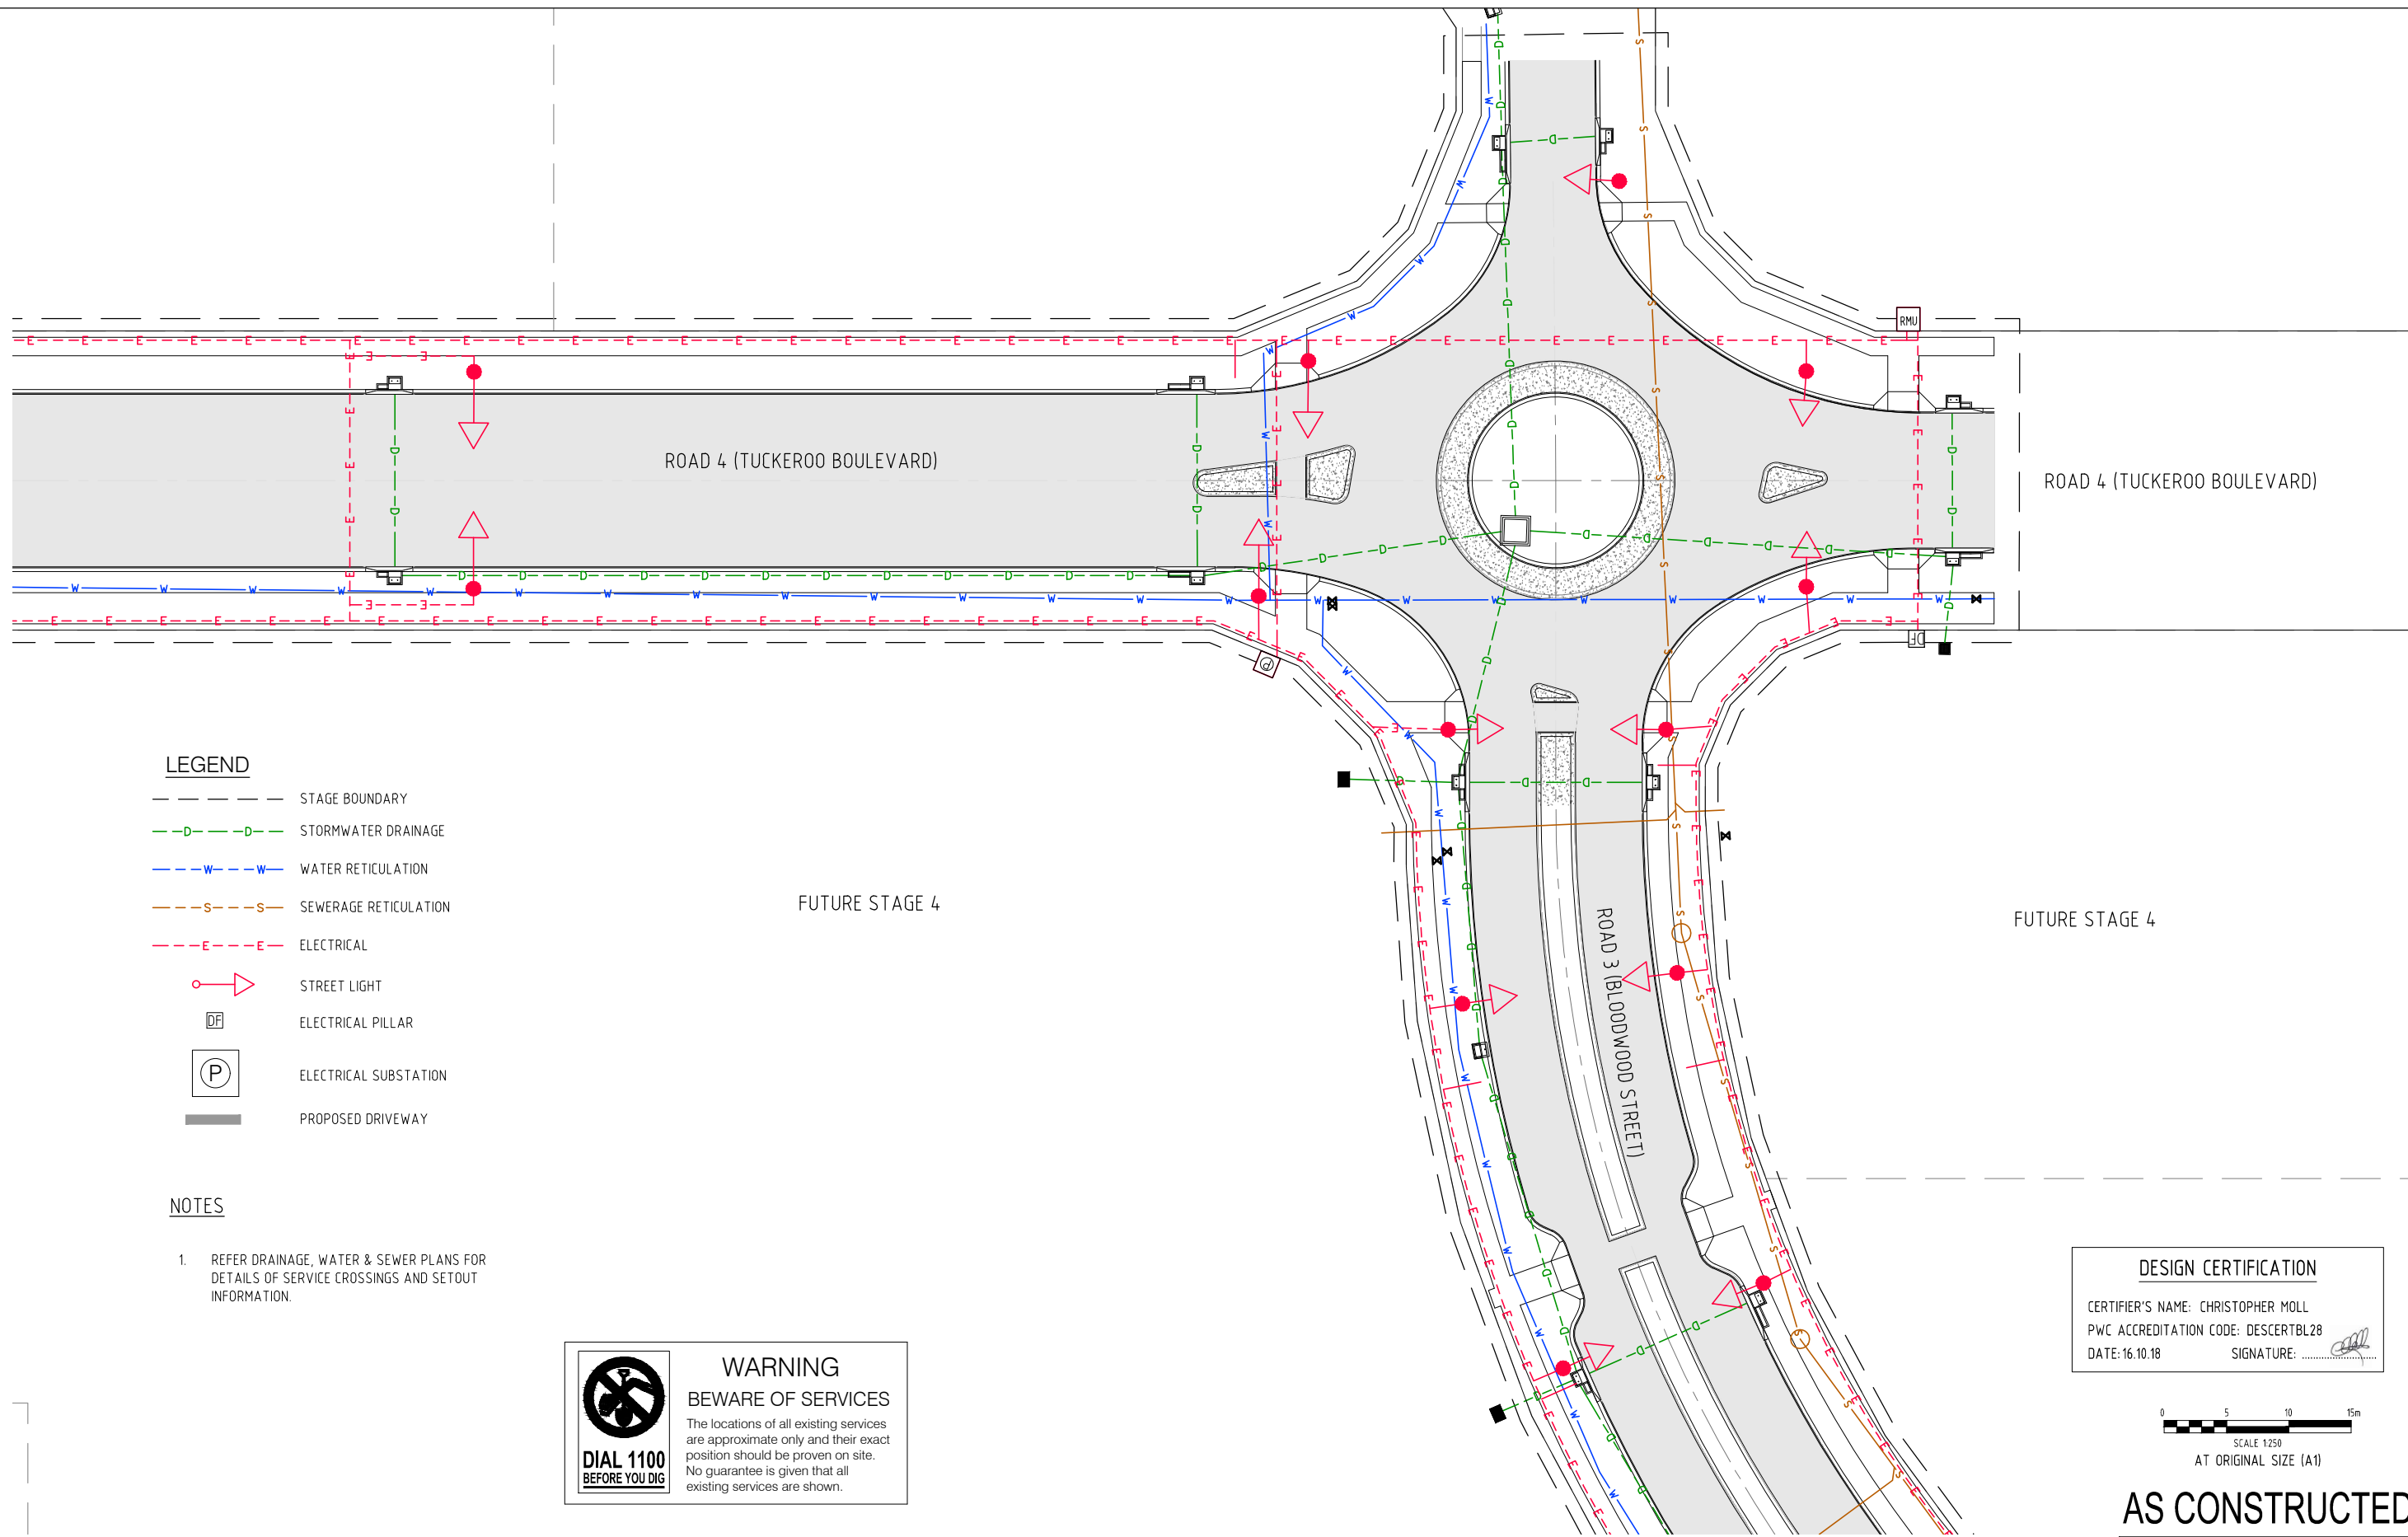

LEGEND

- STAGE BOUNDARY
- D-D- STORMWATER DRAINAGE
- W-W- WATER RETICULATION
- S-S- SEWERAGE RETICULATION
- E-E- ELECTRICAL
- STREET LIGHT
- DF ELECTRICAL PILLAR
- P ELECTRICAL SUBSTATION
- █ PROPOSED DRIVEWAY

NOTES


1. REFER DRAINAGE, WATER & SEWER PLANS FOR DETAILS OF SERVICE CROSSINGS AND SETOUT INFORMATION.

WARNING
BEWARE OF SERVICES

The locations of all existing services are approximate only and their exact position should be proven on site. No guarantee is given that all existing services are shown.

DESIGN CERTIFICATION

CERTIFIER'S NAME: CHRISTOPHER MOLL
PWC ACCREDITATION CODE: DESCERTBL28
DATE: 16.10.18 SIGNATURE:

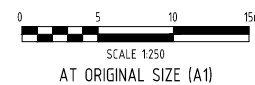

AS CONSTRUCTED

ADG PROJECT 20696 DRG No. B17-6622

NO	DESCRIPTION	DRN	DATE	CKD	APPD
2	AS CONSTRUCTED - ADG	JMB	16.10.18	BL	BL
1	AS CONSTRUCTED - ADG	JMB	15.10.18	SW	CJM
0	ISSUED FOR CONSTRUCTION - FCG	LM	14.07.17	LM	PW
AMENDMENTS					



WARNING
BEWARE OF SERVICES

THE LOCATIONS OF ALL EXISTING SERVICES ARE APPROXIMATE ONLY AND THEIR EXACT POSITION SHOULD BE PROVEN ON SITE. NO GUARANTEE IS GIVEN THAT ALL EXISTING SERVICES ARE SHOWN.




DES	FCG	ZUCCOLI ASPIRE STAGE 3A MASTER SERVICES PLAN SHEET 2 OF 5	
DRN	JB		
CHK	SW		
APPD	CJM		
SCALE	1:250		
ISSUED	16.10.18	A1	DRAWING NUMBER B17-6622
ALL DIM. IN m			
DRAFTING STANDARD TO A.S.1100		CAD PRODUCT - DO NOT AMEND MANUALLY	
			2 AMDT

NOTES

1. REFER DRAINAGE, WATER & SEWER PLANS FOR DETAILS OF SERVICE CROSSINGS AND SETOUT INFORMATION.

DESIGN CERTIFICATION

CERTIFIER'S NAME: CHRISTOPHER MOLL
PWC ACCREDITATION CODE: DESCERTBL28
DATE: 16.10.18 SIGNATURE: 



WARNING
BEWARE OF SERVICES

The locations of all existing services are approximate only and their exact position should be proven on site. No guarantee is given that all existing services are shown.

FUTURE STAGE

ROAD 3 (BLOODWOOD STREET)

ROAD 1

ROAD 10

LEGEND

- STAGE BOUNDARY
- STORMWATER DRAINAGE
- WATER RETICULATION
- SEWERAGE RETICULATION
- ELECTRICAL
- STREET LIGHT
- ELECTRICAL PILLAR
- ELECTRICAL SUBSTATION
- PROPOSED DRIVEWAY

FUTURE STAGE

0 5 10 15m
SCALE 1:250
AT ORIGINAL SIZE (A1)

AS CONSTRUCTED

ADG PROJECT 20696 DRG No. B17-6623

NO	DESCRIPTION	DRN	DATE	CKD	APPD
2	AS CONSTRUCTED - ADG	JMB	16.10.18	BL	BL
1	AS CONSTRUCTED - ADG	JMB	15.10.18	SW	CJM
0	ISSUED FOR CONSTRUCTION - FCG	LM	14.07.17	LM	PW
AMENDMENTS					



Darwin Office
Tenancy 3, Level 1, 5 Edmunds Street,
Darwin, Northern Territory 0800, Australia
GPO Box 2422, Darwin, Northern Territory 0801
T +61 8 807 4100 F +61 8 807 1286
E info@adg.com.au W www.adg.com.au
SHEWAN + DARWIN GOLD COAST + MELBOURNE + NORTH
+ SOUTHERN COAST + SYDNEY + TOWNSVILLE



WARNING
BEWARE OF SERVICES
THE LOCATIONS OF ALL EXISTING SERVICES ARE APPROXIMATE ONLY AND THEIR EXACT POSITION SHOULD BE PROVEN ON SITE. NO GUARANTEE IS GIVEN THAT ALL EXISTING SERVICES ARE SHOWN.




DES	FCG
DRN	JB
CHK	SW
APPD	CJM
SCALE	1:250
ISSUED	16.10.18
ALL DIM. IN m	
DRAFTING STANDARD TO A.S.1100	

ZUCCOLI ASPIRE
STAGE 3A
MASTER SERVICES PLAN
SHEET 3 OF 5

A1 DRAWING NUMBER B17-6623

CAD PRODUCT - DO NOT AMEND MANUALLY

2
AMDT

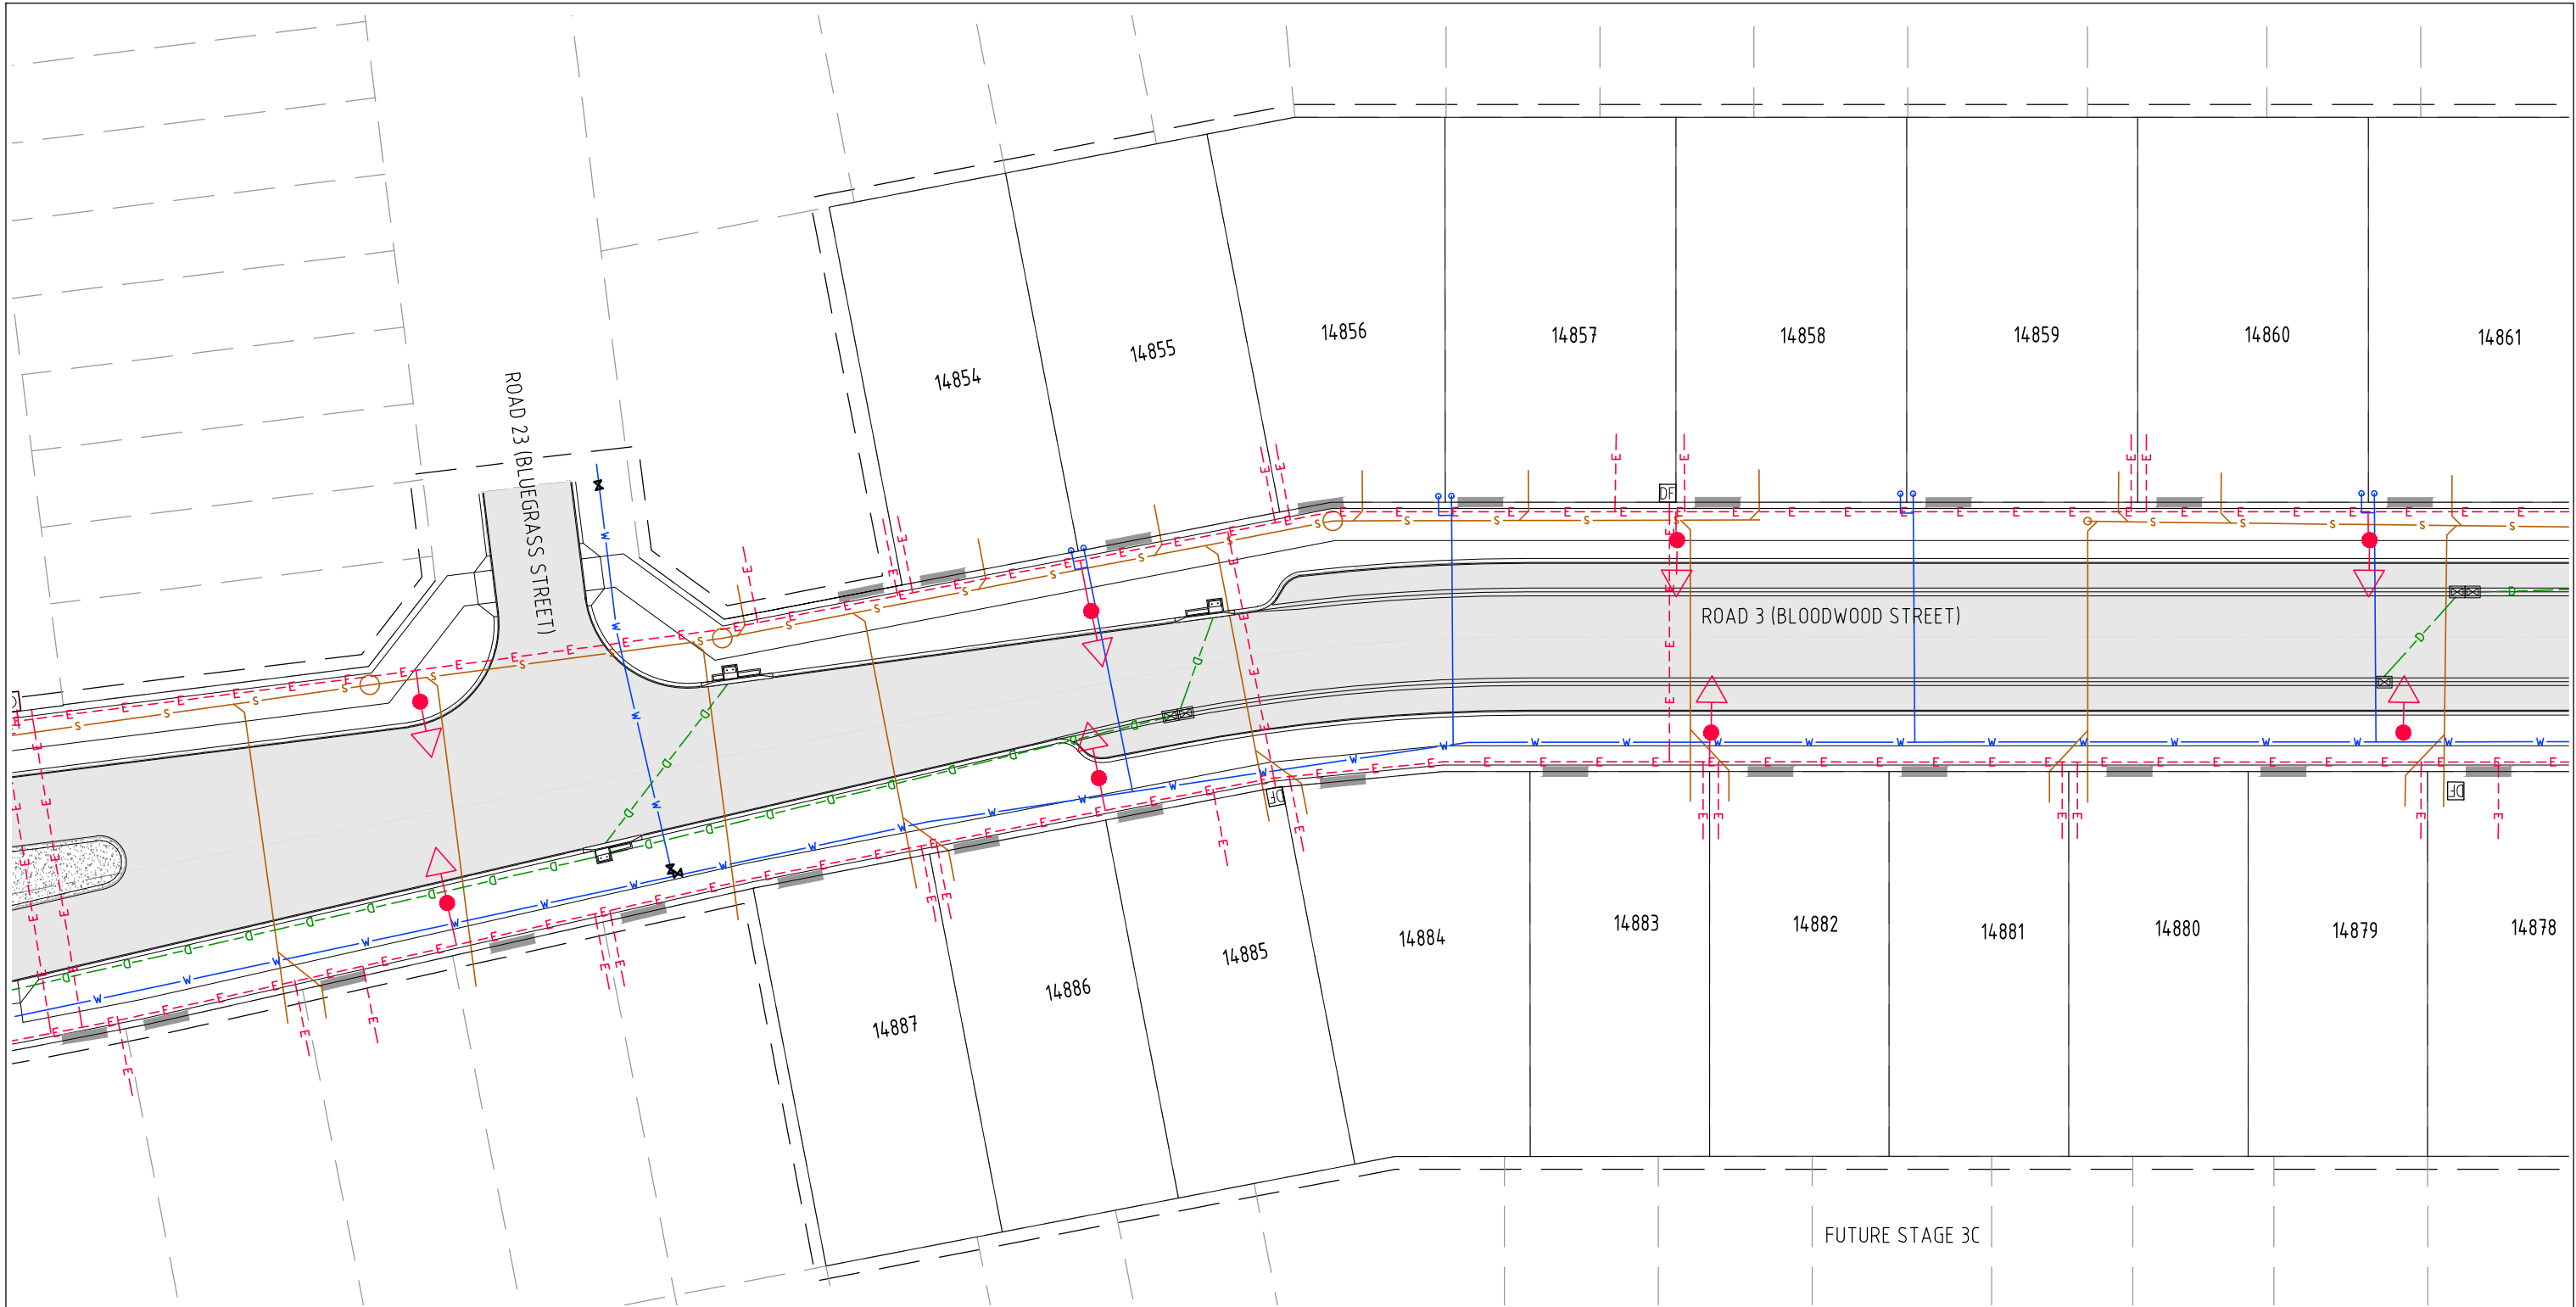

LEGEND

- STAGE BOUNDARY
- D---D--- STORMWATER DRAINAGE
- W---W--- WATER RETICULATION
- S---S--- SEWERAGE RETICULATION
- E---E--- ELECTRICAL
- PROPOSED DRIVEWAY
- STREET LIGHT
- ELECTRICAL PILLAR
- ELECTRICAL SUBSTATION

NOTES

- REFER DRAINAGE, WATER & SEWER PLANS FOR DETAILS OF SERVICE CROSSINGS AND SETOUT INFORMATION.

DESIGN CERTIFICATION

CERTIFIER'S NAME: CHRISTOPHER MOLL
PWC ACCREDITATION CODE: DESCRTBL28
DATE: 16.10.18 SIGNATURE:



WARNING
BEWARE OF SERVICES
The locations of all existing services are approximate only and their exact position should be proven on site. No guarantee is given that all existing services are shown.



AS CONSTRUCTED

ADG PROJECT 20696 DRG No. B17-6624


NO	DESCRIPTION	DRN	DATE	CKD	APPD
2	AS CONSTRUCTED - ADG	JMB	16.10.18	BL	BL
1	AS CONSTRUCTED - ADG	JMB	15.10.18	SW	CJM
0	ISSUED FOR CONSTRUCTION - FCG	LM	14.07.17	LM	PW
AMENDMENTS					



WARNING
BEWARE OF SERVICES
THE LOCATIONS OF ALL EXISTING SERVICES ARE APPROXIMATE ONLY AND THEIR EXACT POSITION SHOULD BE PROVEN ON SITE. NO GUARANTEE IS GIVEN THAT ALL EXISTING SERVICES ARE SHOWN.



DES	FCG	ZUCCOLI ASPIRE STAGE 3A MASTER SERVICES PLAN SHEET 4 OF 5	
DRN	JB		
CHK	SW		
APPD	CJM		
SCALE	1:250		
ISSUED	16.10.18	A1	DRAWING NUMBER B17-6624
ALL DIM. IN m			
DRAFTING STANDARD TO A.S.1100		CAD PRODUCT - DO NOT AMEND MANUALLY	

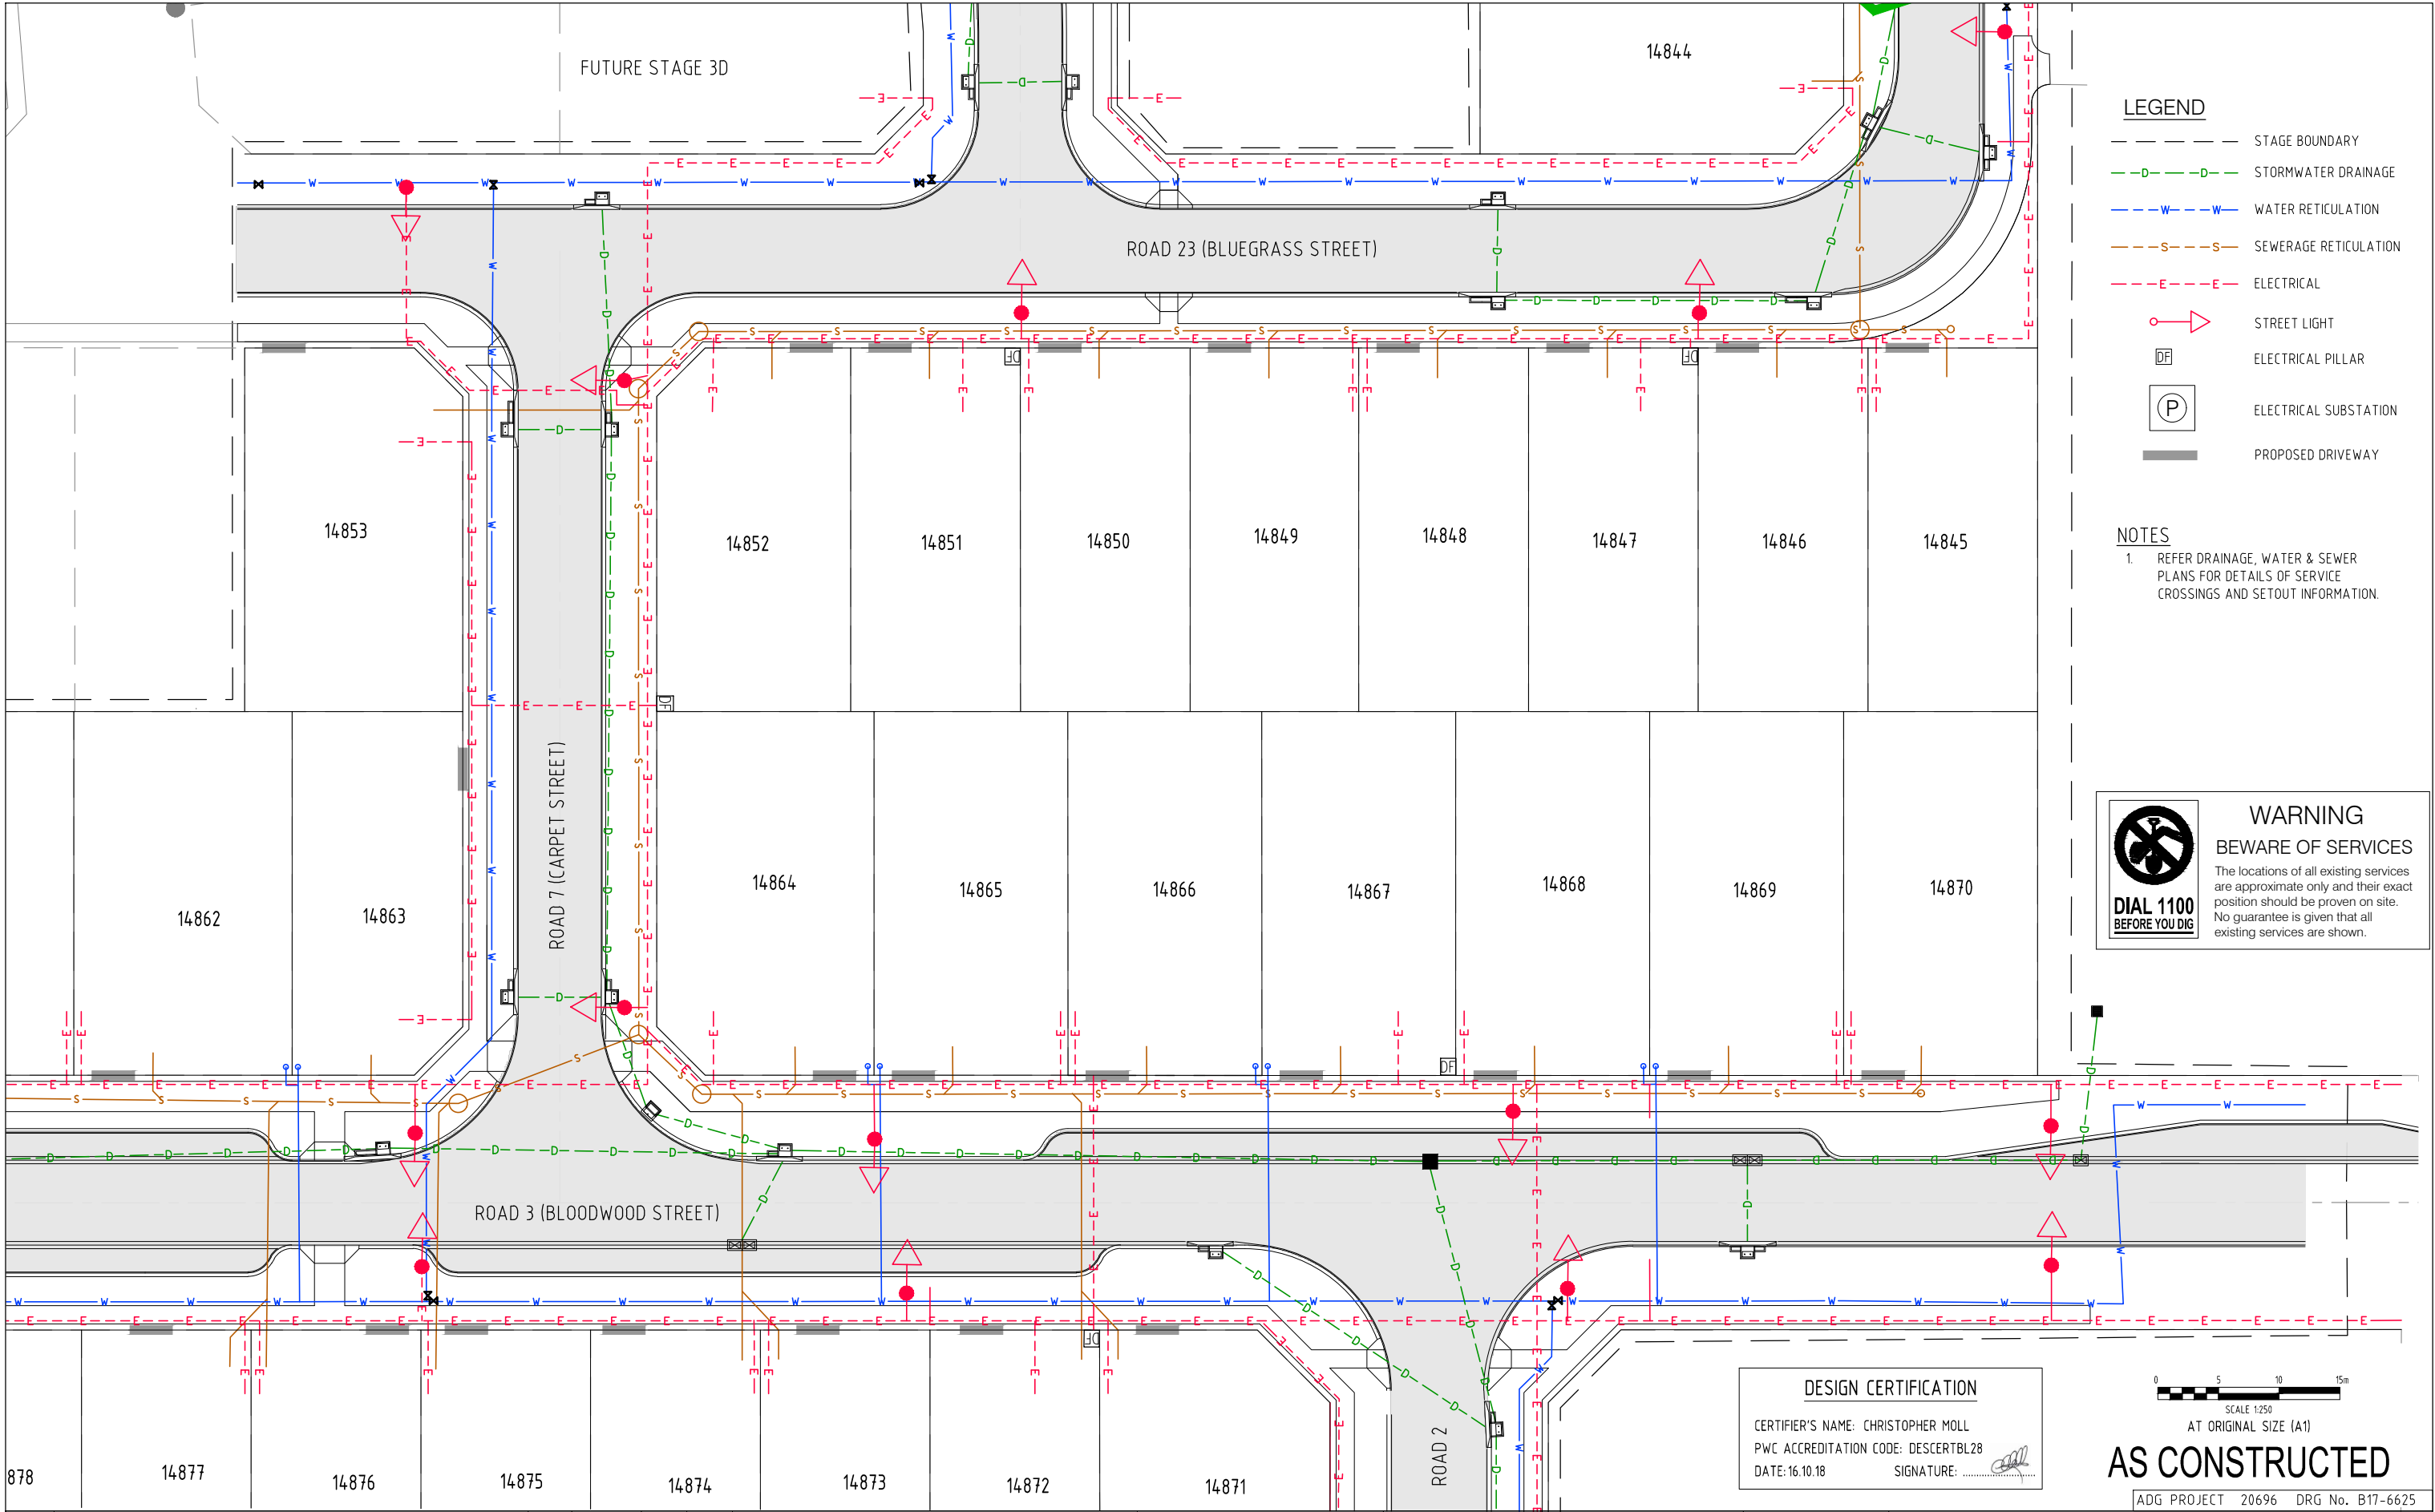

LEGEND

- STAGE BOUNDARY
- STORMWATER DRAINAGE
- WATER RETICULATION
- SEWERAGE RETICULATION
- ELECTRICAL
- STREET LIGHT
- ELECTRICAL PILLAR
- ELECTRICAL SUBSTATION
- PROPOSED DRIVEWAY

NOTES

- REFER DRAINAGE, WATER & SEWER PLANS FOR DETAILS OF SERVICE CROSSINGS AND SETOUT INFORMATION.



WARNING
BEWARE OF SERVICES
The locations of all existing services are approximate only and their exact position should be proven on site. No guarantee is given that all existing services are shown.

DESIGN CERTIFICATION
CERTIFIER'S NAME: CHRISTOPHER MOLL
PWC ACCREDITATION CODE: DESCRTBL28
DATE: 16.10.18
SIGNATURE:

0 5 10 15m
SCALE 1:250
AT ORIGINAL SIZE (A1)

AS CONSTRUCTED

ADG PROJECT 20696 DRG No. B17-6625

NO	DESCRIPTION	DRN	DATE	CKD	APPD
2	AS CONSTRUCTED - ADG	JMB	16.10.18	BL	BL
1	AS CONSTRUCTED - ADG	JMB	15.10.18	SW	CJM
0	ISSUED FOR CONSTRUCTION - FCG	LM	14.07.17	LM	PW
AMENDMENTS					



WARNING
BEWARE OF SERVICES
THE LOCATIONS OF ALL EXISTING SERVICES ARE APPROXIMATE ONLY AND THEIR EXACT POSITION SHOULD BE PROVEN ON SITE. NO GUARANTEE IS GIVEN THAT ALL EXISTING SERVICES ARE SHOWN.



DES	FCG	ZUCCOLI ASPIRE STAGE 3A MASTER SERVICES PLAN SHEET 5 OF 5	
DRN	JB		
CHK	SW		
APPD	CJM		
SCALE	1:250		
ISSUED	16.10.18	A1	DRAWING NUMBER B17-6625
ALL DIM. IN m			
DRAFTING STANDARD TO A.S.1100		CAD PRODUCT - DO NOT AMEND MANUALLY	
			2 AMDT